

**SURVEY &  
REMONUMENTATION**

**FEB 26 1998**

**MECOSTA COUNTY REMONUMENTATION PROGRAM**

**CORNER APPROVED BY PEER GROUP ON November 14, 1997**

STATE OF MICHIGAN  
COUNTY OF MECOSTA  
RECEIVED FOR RECORD

**SECTION**

**LAND CORNER RECORDATION CERTIFICATE**

**Filing Requirement of Act 74, Mich. P.A. 1970**

'97 DEC 22 A8:42

For corners in  
Mecosta  
(County)

Located In:

Corner Code #

Mecosta Township

1. Public Land Survey	SEC 33 T14N R10W	<u>G-13</u>
	T R	
	T R	
	T R	
2. Property Controlling in Section	S T R	
	S T R	
3. Miscellaneous Property in Sec.	S T R	
	S T R	

*James J. Keller*  
REGISTER OF DEEDS

Register of Deeds Stamp & File Number

4. Lot No. \_\_\_\_\_ Recorded Plat \_\_\_\_\_  
5. Private Claims \_\_\_\_\_

	A	B	C	D	E	F	G	H	I	J	K	L	M
1													
2	6	5	4	3	2	1							
3													
4	7	6	9	10	11	12							
5													
6	18	17	16	15	14	13							
7													
8	19	20	21	22	23	24							
9													
10	30	29	28	27	26	25							
11													
12	31	32	33	34	35	36							
13													

I, James J. Keller, in a field survey on Aug-Nov 19 97, do hereby certify that under requirements of P.A. 74, Michigan P.A. of 1970, the corner points mentioned in lines 1 and 2 above were in conformance with regulations and rules therefore as required in the current manual of survey instructions of the United States Department of the Interior, Bureau of Land Management or by a decree of a Court of Law and/or that the corner points mentioned in lines 3, 4 and 5 above were in conformance with the rules of the Michigan Board of Land Surveyors or by a Decree of a Court of Law; established, re-established, monumented, re-monumented, recovered, found as expressed below:

**NOTE: Not more than 4 corners, all in the same town and range, may be recorded on this certificate.**

**A. Description of original monument and accessories and/or subsequent restoration:**

- June 29, 1837, John Hodgson, Deputy Surveyor G.L.O. "Set Post Corner Sections 33 & 34"  
10" White Ash N19°E 14 Links (12.54') 18" Birch N42°W 35 Links (23.10')
- May 28, 1910, Lyman W. June, Mecosta County Surveyor, indicates Closing Corner 3-4, T13N, R10W  
East 2.33 Chains (153.78') (G.L.O. Record)
- June 3, 1920, C.H. Freeman, Mecosta County Surveyor "Set W. Ash Stake" (2.33ch west of Closing Cor.)  
Birch Stump N32½°W 36 Links (23.76') 9" Hemlock S10°E 28 Links (18.48')


**B. Description of corner evidence found and/or method applied in restoring or reestablishing corner:**

November 13, 1997, James J. Keller, R.L.S. #10693 searched for but did not find White Ash Stake (Freeman 1920) No old bearing trees found considered Corner as Obliterated and Set 1/2" Rebar on Line I-13 and H-13 and 153.78' (2.33ch) Westerly of G-1 NOTE: GLO 1837, June 1896, and Freeman 1920 all indicate 2.33 chains.

**C. Description of monument for corner and accessories established to perpetuate locating the position of the corner:**

Accepted and set Remonumentation Monument as a careful and faithful reestablishment of the position of the Original Corner.

- Set 60d and Tag N side 12" Cherry N65°W 34.37'
- Set 60d and Tag S side 12" Maple N54°E 30.31'
- Set 60d and Tag SW side 12" Maple S66°E 13.70'
- Set 60d and Tag W side 14" Hemlock S10°W 10.05'
- Remon Monument N89°16'31"E 153.78'

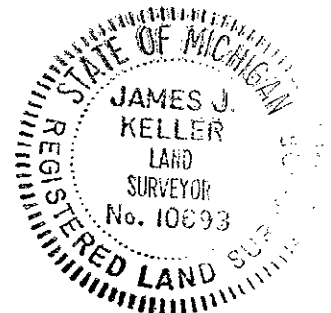

Signed by James J. Keller Date Dec 2 1997  
Surveyor's Michigan License No. 10693

FORM APPROVED BY MICHIGAN STATE BOARD OF LAND SURVEYORS, JAN. 28, 1971  
REVISED MAY 14, 1975  
REVISED JAN., 1983  
ADAPTED FOR WORD PROCESSING MARCH, 1983


APPROVED BY MECOSTA CO. PEER GROUP  
IN ACCORDANCE WITH P.A. 345 OF 1990

James H. Knapp  
CHAIRMAN  
DATE Nov. 14, 1997

Dec, 2, 1997

LJH

as set

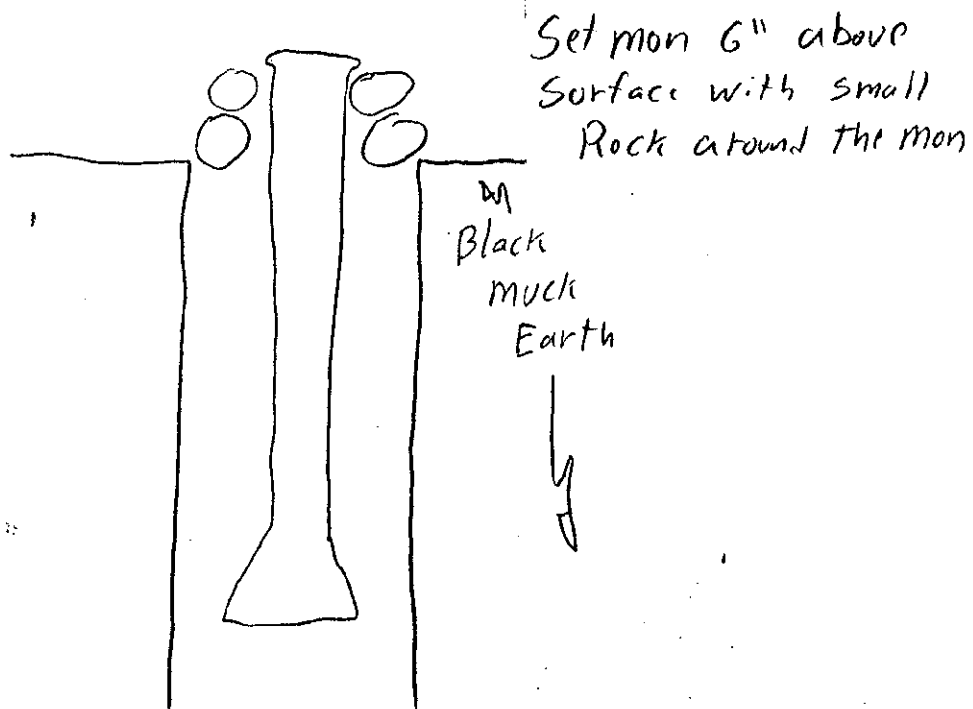

SURVEY &  
REMONUMENTATION

FEB 26 1998

SECTION