

SURVEY &
REMONUMENTATION

MECOSTA COUNTY REMONUMENTATION PROGRAM

CORNER APPROVED BY PEER GROUP ON December 13, 1996

MAY 05 1997

LAND CORNER RECORDATION CERTIFICATE

Filing Requirement of Act 74, Mich. P.A. 1970

For corners in COMMISSION
Mecosta
(County)

Located In:
Mecosta Twp.

Corner Code #

STATE OF MICHIGAN
COUNTY OF MECOSTA
RECEIVED FOR RECORD

'96 DEC 17 AM 1:31

1. Public Land Survey	Sec. 3	T14N	R10W	H-1
		T	R	
		T	R	
		T	R	
2. Property Controlling in Section	S	T	R	
	S	T	R	
3. Miscellaneous Property in Sec.	S	T	R	
	S	T	R	

Joanne Brown
REGISTER OF DEEDS

Register of Deeds Stamp & File Number

4. Lot No. _____, Recorded Plat _____
5. Private Claims _____

I, James J. Keller, in a field survey on Sept.-Oct. 1996, do hereby certify that under requirements of P.A. 74, Michigan P.A. of 1970, the corner points mentioned in lines 1 and 2 above were in conformance with regulations and rules therefore as required in the current manual of survey instructions of the United States Department of the Interior, Bureau of Land Management or by a decree of a Court of Law and/or that the corner points mentioned in lines 3, 4 and 5 above were in conformance with the rules of the Michigan Board of Land Surveyors or by a Decree of a Court of Law, established, re-established, monumented, re-monumented, recovered, found as expressed below:

1	A	B	C	D	E	F	G	H	I	J	K	L	M
2	6	5	4	3	2	1							
3													
4	7	8	9	10	11	12							
5													
6	18	17	16	15	14	13							
7													
8	19	20	21	22	23	24							
9													
10	30	29	28	27	26	25							
11													
12	31	32	33	34	35	36							
13													

NOTE: Not more than 4 corners, all in the same town and range, may be recorded on this certificate.

A. Description of original monument and accessories and/or subsequent restoration:

September 26, 1837 John Hodgson, Deputy Surveyor GLO "Set Quarter Sec. Post" (Sec. 34) original corner (H-1) Not Set.

Ferris Students "Found Stake & Stone"

C/L Gravel North 24.5' 2 Track South, West 2.5' Cedar Fence Post S20°E 31.83'
Cedar Fence Post N06°E 25.15' P.P. with MSHD Tag N50°E 46.20'

July 11, 1972 John David Henry RLS #14875 (Survey L10 P215) refers to Blass Survey L10 P2 (No witnesses given)

July 1, 1976 Jack E. Pierson #19305 (Survey Liber 10, Page 356) "N1/4 Cor Sec 3, 1/2" iron"
14" Stump S68°30'W 65.78' F.P. S35°E 45.34' F.P. N41°42'E 31.71'

November 2, 1979 Gerald J. Gray RLS #17741 (Survey L10 P830-831-832) "Found Iron"
14" Stump S68°W 65.78' Fence Post S35°E 45.34' Fence Post N41°E 31.71'

June 1, 1984 Henry J. Mulder RLS #25862 (Survey L11 P137) "Found 1/2" Iron Rod"
Capped Iron West 8.93' Nail W. side 11" Thornapple S35°E 69.63' Nail N. side Utility Pole N60°E 61.13'
Nail N. side 14" Stump S68°W 65.78' Nail & Tag W. side Fence post N45°E 31.22'

August 6, 1984 Henry J. Mulder RLS #25862 (LCRC L2 P92) "Found 1/2" Iron Rod"
Capped Iron West 8.93' Nail W. side 11" Thornapple S35°E 69.63' Nail N. side Utility Pole N60°E 61.13'
Nail N. side 14" Stump S68°W 65.78' Nail & Tag W. side Fence post N45°E 31.22'

September 30, 1986 Duane F. Wood RLS #24625 (LCRC L2 P129) "Found steel bar"
14" Stump S68°W 65.78' Fence post S35°E 51.20' Fence post N41°E 31.71'

August 29, 1992 Thomas H. Sage RLS #33139 (Survey L11 P986-987) "1/2" Capped Iron"
12" Thornapple S35°E 69.63' 14" Stump S68°W 65.78'
3" Elm N40°W 73.30' Fence post S60°E 55.30'

September 4, 1992 Thomas H. Sage RLS #33139 (LCRC L2 P400) "Found 1/2" Iron W/Obliterated Cap 1" Deep"
"Lowered 1/2" Iron to 4" deep and placed my cap"
1/2" Iron West 8.93' Nail W. side 12" Thornapple S35°E 69.63' C/L Telephone box N60°E 61.60'
Nail & tag E. side 3" Elm N40°W 73.30' Nail & tag N. side Fence post S60°E 55.30'

September 22, 1994 Thomas H. Sage RLS #33139 (Survey L11 P983-984-985) "1/2" Capped Iron #33139"
12" Thornapple S35°E 69.63' 14" Stump S68°W 65.78' Fence post S60°E 55.30' 3" Elm N40°W 73.30'

B. Description of corner evidence found and/or method applied in restoring or reestablishing corner.

November 22, 1996 J.J. Keller RLS #10693 "Found rebar flush South & alongside 1'x1'x2' Stone"
Found Nail & tag N. side 4" Elm N37°W 86.58' Found 1/2" Iron N82°W 28.10'
Found Nail & tag W. side 12" Thornapple South 61.56'

MAR 22 1997


C. Description of monument for corner and accessories established to perpetuate locating the position of the corner.

Accepted 1/2" Rebar over old Sleigh shoe next to stone & Set Remonumentation monument as a careful and faithful perpetuation of the original corner.

Set 60d & tag E. side 16" Oak N03°E 155.18' Set 60d & tag over nail & tag #33139 NE. side 4" Elm N37°W 86.58
Set 60d & tag over nail 12" Thornapple S01°E 61.56' 1/2" Rebar N82°W 28.10 (H-13 - S 1/4 corner Sec 34-15-10
Set 60d & tag N. side 6" Ash S67°E 89.45'

Signed by James J. Keller Date December 13, 1996

Surveyor's Michigan License No. 10693

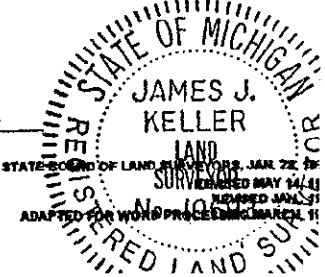

FORM APPROVED BY MICHIGAN STATE BOARD OF LAND SURVEYORS, JAN. 22, 1978
REVISED MAY 14, 1981
ADAPTED FOR WORD PROCESSING MARCH 11, 1996

NOV 22 1996

JJK LJH

