

SURVEY & REMONUMENTATION

MECOSTA COUNTY REMONUMENTATION PROGRAM

SEP 12 1996

CORNER APPROVED BY PEER GROUP ON June 20, 1996

COMMISSION

LAND CORNER RECORDATION CERTIFICATE

Filing Requirement of Act 74, Mich. P.A. 1970

STATE OF MICHIGAN
COUNTY OF MECOSTA
RECEIVED FOR RECORD

For corners in <u>Mecosta</u> (County)	Located In: Mecosta Township	Corner Code # <u>H-3</u>
1. Public Land Survey	SEC 10 T 14N R 10W T _____ R _____ T _____ R _____ T _____ R _____	_____
2. Property Controlling in Section	S _____ T _____ R _____ S _____ T _____ R _____	_____
3. Miscellaneous Property in Sec.	S _____ T _____ R _____ S _____ T _____ R _____	_____
4. Lot No. _____, Recorded Plat _____		
5. Private Claims _____		

'96 AUG 21 A10:31

Jeanne Brown
REGISTER OF DEEDS

Register of Deeds Stamp & File Number

	A	B	C	D	E	F	G	H	I	J	K	L	M
1													
2	6	5	4	3	2	1							
3				●									
4	7	8	9	10	11	12							
5													
6	18	17	16	15	14	13							
7													
8	19	20	21	22	23	24							
9													
10	30	29	28	27	26	25							
11													
12	31	32	33	34	35	36							
13													

I, James J. Keller, in a field survey on May 10, 1996, do hereby certify that under requirements of P.A. 74, Michigan P.A. of 1970, the corner points mentioned in lines 1 and 2 above were in conformance with regulations and rules therefore as required in the current manual of survey instructions of the United States Department of the Interior, Bureau of Land Management or by a decree of a Court of Law and/or that the corner points mentioned in lines 3, 4 and 5 above were in conformance with the rules of the Michigan Board of Land Surveyors or by a Decree of a Court of Law; established, re-established, monumented, re-monumented, recovered, found as expressed below:

NOTE: Not more than 4 corners, all in the same town and range, may be recorded on this certificate.

A. Description of original monument and accessories and/or subsequent restoration:

Sept 25, 1837 John Hodgson, Deputy Surveyor GLO, completed township boundary.

February 26, 1838 Abner E. Van Ness, Deputy Surveyor, GLO. "Set quarter Section Post"
9" Ironwood S70°W 14 links = 9.24'
8" Beech S70 1/2°E 24 links = 15.84'

July 9, 1964 Harlan J. Ptaszenski MSHD Survey Chief (LCRC L1 P49)
Corner object not noted
19" Elm S50°W 67.70'
21" Elm N55°W 57.18'
Telephone Pole N40°E 54.80'
Telephone Pole S30°E 76.04'

Aug. 21 1975 Douglas W. Hooth RLS. #7966 (LCRC L1-P203) Found 1/2" pipe buried 4" deep, North edge East-West road & Centerline trail North & 8' West of trail South.
3/4" pipe flush N79°20'55"E 13.19'
21" Dead Elm N40°W 48.60'
Telephone Pole N50°E 65.34'
Cor fence post S43°E 68.76'
19" Dead Elm S40°W 57.89'

November 11, 1979 Jack E. Pierson RLS #19305 (Survey L11 P32) Found 1/2" IP
3/4" pipe N79°E 13.19'
21" Dead Elm N40°W 48.60'
Telephone pole N50°E 65.34'
F.P. S43°E 68.76'

March 17, 1987 Duane F. Wood RLS #24625 (LCRC L2 P171) Found Copper Bar in Mon. Box.
Centerline Road South 7.1'
Telephone Pole N45°E 65.3'
Telephone Pole S50°E 92.4'
9" Maple N40°W 61.00'

August 9, 1991 James J. Keller RLS #10693 (Survey #5169-A) Found 5/8" Iron in Mon. Box.
Centerline 11 Mile Road South 7.3'
East end angle fence post S39°W 51.45'
Found Nail in 8" Maple N39°W 61.00'
Telephone box N45°E 67.96'
NW Corner Brick Building S53°E 120.68'

Continued on back

APPROVED BY MECOSTA CO. PEER GROUP
IN ACCORDANCE WITH P.A. 345 of 1990

James J. Knapp
CHAIRMAN
DATE JUNE 20, 1996




B. Description of corner evidence found and/or method applied in restoring or reestablishing corner.

May 10, 1996 James J. Keller RLS #10693 (Survey 5169-A) Found 5/8" Iron in Mon. Box
Centerline 11 Mile Road South 7.3'
East end angle fence post S39°W 51.45'
Found 60d nail in 12" Maple N39°W 61.00'
Telephone box N45°E 67.96'
NW Corner Brick Building S53°E 120.68'

C. Description of monument for corner and accessories established to perpetuate locating the position of the corner.

Accept 5/8" iron in Monument Box and set Remonumentation Monument and is accepted as a careful and faithful perpetuation of the position of the original corner.

Set 60d and Tag NE side 12" Maple N38°W 61.00'
Set 60d and Tag West side 8" Maple N20°E 77.02'
East end steel fence post corner S39°W 51.45'
NW corner brick building S54°E 120.75'
C/L of 11 Mile Rd. South 7.2'
Checked for 3/4" Pipe at N79°E 13.19' - not found

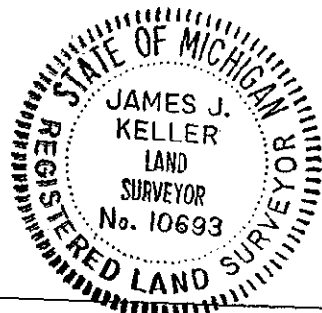

Signed by

James J. Keller

Date

June 21, 1996

Surveyor's Michigan License No

10693

FORM APPROVED BY MICHIGAN STATE BOARD OF LAND SURVEYORS, JAN. 28, 1971
REVISED MAY 14, 1976
REVISED JAN. 1983
ADAPTED FOR WORD PROCESSING MARCH, 1983

July 15 1995

LJH TDB

