

SURVEY & REMONUMENTATION

MECOSTA COUNTY REMONUMENTATION PROGRAM

SEP 12 1996

CORNER APPROVED BY PEER GROUP ON June 20, 1996

COMMISSION

LAND CORNER RECORDATION CERTIFICATE

Filing Requirement of Act 74, Mich. P.A. 1970

STATE OF MICHIGAN
COUNTY OF MECOSTA
RECEIVED FOR RECORD

For corners in

Mecosta

(County)

Located In:

Mecosta Township

Corner Code #

1. Public Land Survey	SEC10	T 14N	R 10W	H-4
		T	R	
		T	R	
		T	R	
		T	R	
2. Property Controlling in Section	S	T	R	
	S	T	R	
3. Miscellaneous Property in Sec.	S	T	R	
	S	T	R	

'96 AUG 21 A10:32

Joanna Brown
REGISTER OF DEEDS

Register of Deeds Stamp & File Number

4. Lot No. _____ Recorded Plat _____
5. Private Claims _____

I, James J. Keller, in a field survey on May 10, 19 96, do hereby certify that under requirements of P.A. 74, Michigan P.A. of 1970, the corner points mentioned in lines 1 and 2 above were in conformance with regulations and rules therefore as required in the current manual of survey instructions of the United States Department of the Interior, Bureau of Land Management or by a decree of a Court of Law and/or that the corner points mentioned in lines 3, 4 and 5 above were in conformance with the rules of the Michigan Board of Land Surveyors or by a Decree of a Court of Law; established, re-established, monumented, re-monumented, recovered, found as expressed below:

NOTE: Not more than 4 corners, all in the same town and range, may be recorded on this certificate.

A. Description of original monument and accessories and/or subsequent restoration:

Not set by GLO

September 4, 1975 Douglas W. Hooth #7966 MSHD (LCRC L1 P214) Found Concrete Monument buried 18" Deep in center of East-West Road and on West edge of N-S trail.
TP. Guy N50°W 52.42'
P. Pole N20°E 86.92"
Cemetery Angle Iron Fence Corner post N45°E 46.29'
T. Pole S55°E 89.72'

April 19, 1991 James J. Keller RLS #10693, Found Concrete Monument 18" deep in centerline East-West road (Hayes Road)
Set FK. Cor fence post. N38°W 51.13'
Found MSHD tag in power pole N24°E 86.91'
Stop sign S26°E 48.07'
Set 30d 25" Maple N78°E 115.11'

B. Description of corner evidence found and/or method applied in restoring or reestablishing corner:

May 10, 1996 James J. Keller RLS #10693 Found 1" IP Flush with Asphalt
Found FK East side Corner fence post N38°W 51.13'
Found MSHD tag in Power Pole N24°E 86.91'
Found 30d 25" Maple N78°E 115.11'


C. Description of monument for corner and accessories established to perpetuate locating the position of the corner:

Accept concrete monument and replace with Remonumentation Monument and is accepted as a careful and faithful perpetuation of the position of the original corner.

Found 1" IP Flush with Asphalt over the center of a concrete monument 18" deep
Set 60d nail and tag SW side 26" Maple N78°E 115.09'
Set 60d nail and tag West side Power Pole N22°E 86.90'
Set FK and tag East side Corner fence post N41°W 51.29'
Set 60d nail and tag West side 6" triple Cherry S13°E 116.70'

APPROVED BY MECOSTA CO. PEER GROUP
IN ACCORDANCE WITH P.A. 343 of 1990

James J. Knapp
CHAIRMAN
DATE JUNE 20, 1996

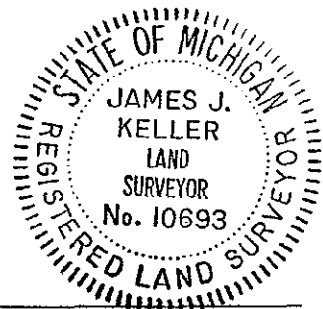

Signed by James J. Keller


Date June 21, 1996

Surveyor's Michigan License No. 10693

FORM APPROVED BY MICHIGAN STATE BOARD OF LAND SURVEYORS, JAN. 28, 1971
REVISED MAY 14, 1975
REVISED JAN. 1983
ADAPTED FOR WORD PROCESSING MARCH, 1993

July 15 1995

LJH, TDB

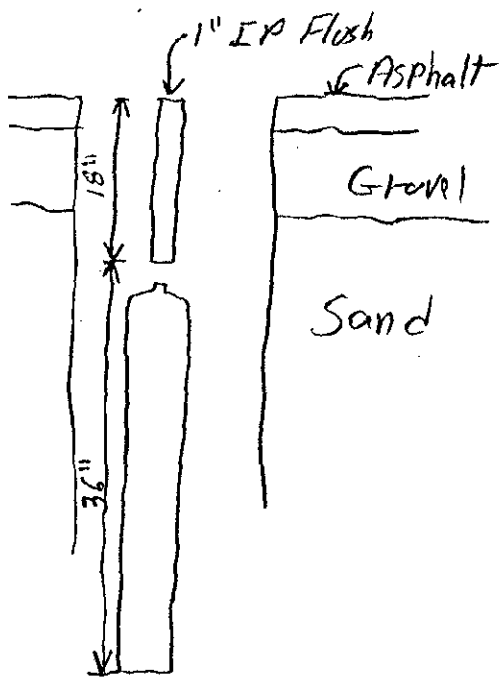

as Found

