

SURVEY & REMONUMENTATION MECOSTA COUNTY REMONUMENTATION PROGRAM

CORNER APPROVED BY PEER GROUP ON June 20, 1996

SEP 12 1996

LAND CORNER RECORDATION CERTIFICATE

Filing Requirement of Act 74, Mich. P.A. 1970

STATE OF MICHIGAN
COUNTY OF MECOSTA
RECEIVED FOR RECORD

COMMISSION

For corners in

Mecosta
(County)

Located In:

Corner Code #

'96 AUG 21 AM 10:32

- | | | | | |
|------------------------------------|-------|-------|-------|-----|
| 1. Public Land Survey | SEC10 | T 14N | R 10W | H-5 |
| | | T | R | |
| | | T | R | |
| | | T | R | |
| 2. Property Controlling in Section | S | T | R | |
| | S | T | R | |
| 3. Miscellaneous Property in Sec. | S | T | R | |
| | S | T | R | |

Joanna Brown
REGISTER OF DEEDS

Register of Deeds Stamp & File Number

4. Lot No. _____ Recorded Plat _____
5. Private Claims _____

I, James J. Keller, in a field survey on May 22 1996, do hereby certify that under requirements of P.A. 74, Michigan P.A. of 1970, the corner points mentioned in lines 1 and 2 above were in conformance with regulations and rules therefore as required in the current manual of survey instructions of the United States Department of the Interior, Bureau of Land Management or by a decree of a Court of Law and/or that the corner points mentioned in lines 3, 4 and 5 above were in conformance with the rules of the Michigan Board of Land Surveyors or by a Decree of a Court of Law; established, re-established, monument, re-monumented, recovered, found as expressed below:

	A	B	C	D	E	F	G	H	I	J	K	L	M
1													
2	6	5	4	3	2	1							
3													
4	7	8	9	10	11	12							
5													
6	18	17	16	15	14	13							
7													
8	19	20	21	22	23	24							
9													
10	30	29	28	27	26	25							
11													
12	31	32	33	34	35	36							
13													

NOTE: Not more than 4 corners, all in the same town and range, may be recorded on this certificate.

A. Description of original monument and accessories and/or subsequent restoration:

3rd Quarter 1838, John Hodgson, Deputy Surveyor, GLO. Completed Township Boundary

1st Quarter 1839, Abner E. Van Ness Deputy Surveyor, GLO. "Set quarter section post"
12" Hemlock South 13 links = 8.58'
12" Beech North 24 links = 15.84'

Sept. 3, 1975 Douglas W. Hooth MSHD RLS. #7966 (LCRC L1 P204) Found 4" Concrete Monument with 1/2" Iron rod between trails.
13" Maple S50°W 57.02'
33" Maple S30°W 69.08'
9" N. Pine N70°W 48.64'
9" N. Pine N45°W 71.54'

March 12, 1993 Carl F. Roser RLS #12028 Drove 5/8"x 34" rerod w/LS cap.
17" S. Maple S50°W 57.02'
38" S. Maple S25°W 69.08'
16" W. Pine S85°E 78.24'
9" R. Pine S75°W 53.62'

APPROVED BY MECOSTA CO. PEER GROUP
IN ACCORDANCE WITH P.A. 345 of 1990
James S. Knapp
CHAIRMAN
DATE JUNE 20, 1996

B. Description of corner evidence found and/or method applied in restoring or reestablishing corner:

May 22, 1996 James J. Keller RLS. #10693, Found 1/2" Rebar with DNR. cap #12028 6" deep next to grader blade in nest of stones.
Found 30d N. side 10" Red. Pine S81°W 53.62'
Found 30d SE. side 16" Maple S54°W 57.04'
Found 30d NW. side 36" Maple S32°W 69.08'
Found 40d S. side 15" Red Pine S77°E 78.22'


C. Description of monument for corner and accessories established to perpetuate locating the position of the corner:

Set Remonumentation Monument and is accepted as a careful and faithful perpetuation of the position of the Original Corner.

- Set 60d & Tag NW side 32" Maple S30°W - 69.09'
- Set 60d & Tag SE side 18" Maple S51°W - 57.01'
- Set 60d & Tag N side 10" Red Pine S79°W - 53.64'
- Set 60d & Tag S side 14" White Pine S79°E - 78.31'

Signed by *James J. Keller*
Surveyor's Michigan License No. 10693

Date June 20, 1996

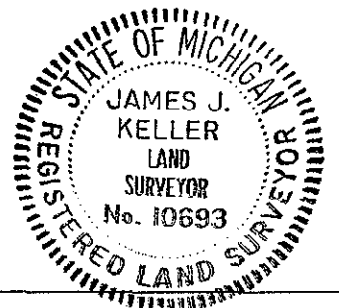

1
N

