

SURVEY & REMONUMENTATION

MECOSTA COUNTY REMONUMENTATION PROGRAM

OCT 29 1998

CORNER APPROVED BY PEER GROUP ON December 13, 1996

LAND CORNER RECORDATION CERTIFICATE

Filing Requirement of Act 74, Mich. P.A. 1970

STATE OF MICHIGAN
COUNTY OF MECOSTA
RECEIVED FOR RECORD

SECTION

For corners in

Mecosta

(County)

Located In:
Mecosta Twp.

Corner Code #

'98 SEP -8 A9 :03

1. Public Land Survey	SEC 2	T14N	R 10W	I-1
		T	R	
		T	R	
		T	R	
2. Property Controlling in Section	S	T	R	
	S	T	R	
3. Miscellaneous Property in Sec.	S	T	R	
	S	T	R	

James Brown
REGISTER OF DEEDS

Register of Deeds Stamp & File Number

4. Lot No. _____, Recorded Plat _____
5. Private Claims _____

I, James J. Keller, in a field survey on Sept-Oct 19 96, do hereby certify that under requirements of P.A. 74, Michigan P.A. of 1970, the corner points mentioned in lines 1 and 2 above were in conformance with regulations and rules therefore as required in the current manual of survey instructions of the United States Department of the Interior, Bureau of Land Management or by a decree of a Court of Law and/or that the corner points mentioned in lines 3, 4 and 5 above were in conformance with the rules of the Michigan Board of Land Surveyors or by a Decree of a Court of Law; established, re-established, monumented, re-monumented, recovered, found as expressed below:

NOTE: Not more than 2 corners, all in the same town and range, may be recorded on this certificate.

A. Description of original monument and accessories and/or subsequent restoration:

- November 30, 1837, Abner E. VanNess, Deputy Surveyor GLO "Intersected North Boundary 50 links (33.0') West of Post & Set Post Cor. to Sect. 2 & 3" Sugar 18in Diam
- September 9, 1971, Clinton E. Cole, RLS #17615 (Survey L10 P2) "R.R. spike"
24" Maple N74°E 105.72' 12" Maple N65°W 69.92'
Utility Pole S68°W 52.42'
- July 1, 1976, Jack E. Pierson, RLS #19305 (Survey L10 P356) "R.R. Spike"
24" Maple N74°E 105.70' 12" Maple N65°W 69.90'
P Pole S68°W 52.40'
- May 16, 1979, Duane F. Wood, RLS #24625 (Survey L10 P694) "Found R.R. Spike"
12" Maple N65°W 69.9' Power pole S68°W 52.4'
C/L US 131 East 7.2'
- July 5, 1979, Gerald J. Gray, RLS #17741 (Survey L10 P738)
SE Corner Section 34, East 33'
- August 14, 1979, Gerald J. Gray, RLS #17741 (LCRC L1 P511) "Found R.R. Spike"
12" Maple N65°W 69.9' Power pole S68°W 52.4'
Centerline US 131 East 7.2'
- June 1, 1984, Henry J. Mulder, RLS #25862 (Survey L11 P137) "Found R.R. Spike 7.2' West of US 131"
24" Maple N74°E 105.7' 12" Maple N65°W 69.9'
P. Pole S68°W 57.4'
- August 29, 1992, Thomas H. Sage, RLS #33139 (Survey L11 P986-987) "R.R. Spike 7.2' West C/L"
24" Maple S74°E 105.7' 12" Maple N65°W 69.9'
P. Pole S68°W 57.4'
- September 22, 1994, Thomas H. Sage, RLS #33139 (Survey L11 P983-984-985) "R.R. Spike 7.2' West of C/L"
24" Maple S74°E 105.7' 12" Maple N65°W 69.9'
P. Pole S68°W 57.4'
- Circa 1975 Ferris Students "Found R.R. Spike"
Found Bent 3/4" Iron East 33' P. Pole S68°W 52.4'
12" Maple N65°W 69.9' 24" Maple N74°E 105.7'
- July 29, 1996, Duane F. Wood, RLS #24625 (Survey L12 P91) "R.R. Spike"
18" Maple N65°W 69.6' 24" Maple N70°E 105.5'
P. Pole S75°W 52.0'

	A	B	C	D	E	F	G	H	I	J	K	L	M
1													
2	6	5	4	3	2	1							
3													
4	7	8	9	10	11	12							
5													
6	18	17	16	15	14	13							
7													
8	19	20	21	22	23	24							
9													
10	30	29	28	27	26	25							
11													
12	31	32	33	34	35	36							
13													

APPROVED BY MECOSTA CO. PEER GROUP
IN ACCORDANCE WITH P.A. 345 of 1990

James B. Krupp
CHAIRMAN
DATE DEC. 13, 1996


B. Description of corner evidence found and/or method applied in restoring or reestablishing corner:

- July 9, 1997, James J. Keller, RLS #10693 (Field Book 138-W P39) "R.R. Spike"
Remonumentation Monument in box at SW corner Section 35, T15N, R10W
S89°27'E 32.98'

C. Description of monument for corner and accessories established to perpetuate locating the position of the corner:

- Accepted railroad spike and set Remonumentation Monument in concrete as a careful and faithful perpetuation of the location of the position of the original corner.
End 60d and tag S sd 24" Maple N68°14'W 69.76'
End Pk nail and tag NW sd Power Pole N58°50'E 60.92'
NE anchor bolt S62°19'E 77.60'
End Pk nail and tag N sd Power Pole S68°34'W 52.71'

Signed by James J. Keller Date July 10, 1997
Surveyor's Michigan License No. 10693

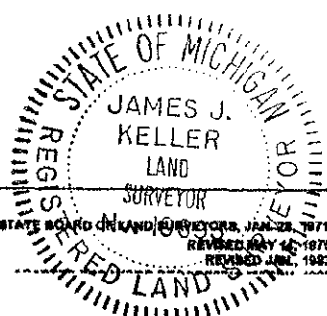

FORM APPROVED BY MICHIGAN STATE BOARD OF LAND SURVEYORS, JAN. 28, 1971
REVISED MAY 14, 1975
REVISED JUNE, 1983