

MECOSTA COUNTY REMONUMENTATION PROGRAM

STATE OF MICHIGAN
COUNTY OF MECOSTA
RECEIVED FOR RECORD

MAR 14 2000

CORNER APPROVED BY PEER GROUP ON August 13, 1999

LAND CORNER RECORDATION CERTIFICATE

Filing Requirement of Act 74, Mich. P.A. 1970

'99 NOV 15 P2:41

SECTION

For corners in Mecosta Located In: Mecosta Twp. Corner Code # _____
 (County)

1. Public Land Survey	SEC 27 T 14N R 10W	I-10
	T _____ R _____	_____
	T _____ R _____	_____
	T _____ R _____	_____
2. Property Controlling in Section	S _____ T _____ R _____	_____
	S _____ T _____ R _____	_____
3. Miscellaneous Property in Sec.	S _____ T _____ R _____	_____
	S _____ T _____ R _____	_____

4. Lot No. _____, Recorded Plat _____

5. Private Claims _____

Joann Brown
REGISTER OF DEEDS

Register of Deeds Stamp & File Number

	A	B	C	D	E	F	G	H	I	J	K	L	M
1													
2	6	5	4	3	2	1							
3													
4	7	8	9	10	11	12							
5													
6	18	17	16	15	14	13							
7													
8	19	20	21	22	23	24							
9													
10	30	29	28	27	26	25							
11													
12	31	32	33	34	35	36							
13													

I, James J. Keller, in a field survey on July 20, 1999, do hereby certify that under requirements of P.A. 74, Michigan P.A. of 1970, the corner points mentioned in lines 1 and 2 above were in conformance with regulations and rules therefore as required in the current manual of survey instructions of the United States Department of the Interior, Bureau of Land Management or by a decree of a Court of Law and/or that the corner points mentioned in lines 3, 4 and 5 above were in conformance with the rules of the Michigan Board of Land Surveyors or by a Decree of a Court of Law, established, re-established, monumented, re-monumented, recovered, found as expressed below:

NOTE: Not more than 2 corners, all in the same town and range, may be recorded on this certificate.

A. Description of original monument and accessories and/or subsequent restoration:

- November 29, 1837, Abner E. Van Ness, Deputy Surveyor GLO "Set Cr. Sec. Post" Ironwood 6in. diam.
- September 14-15, 1898, Lyman W. June, County Surveyor (Record Book 1 P296) (Field Book 3 P14-15) "Set Stone over old Stake"
- December 12, 1975, Douglas W. Hooth, RLS #7966, MSED Surveyor (LCRC L1 P251) "Found Large Stone 4ft below centerline of rd. North & South & rd. East & West. Placed 3/4" x 4ft pipe on top of Large stone"
14" Maple S66°W 46.73' 27" Maple S30°E 42.07' 23" S. Maple N35°E 38.78'
- June 28, 1991, James J. Keller, RLS #10693 "Found 3/4" IP 8" Deep". No Witnesses Taken.

B. Description of corner evidence found and/or method applied in restoring or reestablishing corner:


- July 20, 1999, James J. Keller, RLS #10693 (FB 138-W P90) "Found 3/4" IP 8" Below Grade"
Set 60d SE sd 8" Ash N25°E 71.13'
Set 60d SW sd 28" Maple S20°E 57.08'
Set 60d SE sd 44" R. Oak S30°W 67.00'
Set 60d NW sd 14" Walnut S55°W 31.67'
- NOTE: All the above witnesses were removed due to road construction early September 1999.

- September 27, 1999, James J. Keller, RLS #10693 (FB 138-W P109) "Found 3/4" IP 8" Below Grade"
Set 60d SE sd 12" Maple N44°E 72.43'
Set 60d NE sd 12" Maple N64°W 40.63'
Set 60d NW sd 6" R. Oak S70°W 45.12'
Set 60d SW sd 6" Walnut S55°E 70.74'

C. Description of monument for corner and accessories established to perpetuate locating the position of the corner:

Accepted 3/4" IP and set Remonumentation Monument in place of it as a careful and faithful perpetuation of the original corner.

- Found 60d and set tag SE sd 12" Maple N44°E 72.43'
- Found 60d and set tag NE sd 12" Maple N64°W 40.63'
- Found 60d and set tag NW sd 6" R. Oak S70°W 45.12'
- Found 60d and set tag SW sd 6" Walnut S55°E 70.74'

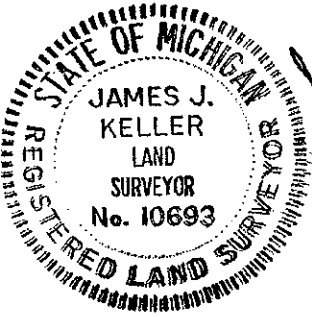

APPROVED BY MECOSTA CO. PEER GROUP
IN ACCORDANCE WITH P.A. 345 of 1990
James J. Knapp
CHAIRMAN
DATE Aug. 13, 1999

Signed by *James J. Keller* Date November 1, 1999
 Surveyor's Michigan License No. 10693