

SURVEY & REMONUMENTATION COMMISSION
 SEP 12 1996

MECOSTA COUNTY REMONUMENTATION PROGRAM

CORNER APPROVED BY PEER GROUP ON April 15, 1996

LAND CORNER RECORDATION CERTIFICATE

Filing Requirement of Act 74, Mich. P.A. 1970

STATE OF MICHIGAN
 COUNTY OF MECOSTA
 RECEIVED FOR RECORD

For corners in Mecosta Located In: _____ Corner Code # _____
 (County)

'96 AUG 21 A10:31

1. Public Land Survey	Sec. 34	T 14N	R 10W	I-11
		T	R	
		T	R	
		T	R	
2. Property Controlling in Section	S	T	R	
	S	T	R	
3. Miscellaneous Property in Sec.	S	T	R	
	S	T	R	

Joanne Brown
 REGISTER OF DEEDS

Register of Deeds Stamp & File Number

4. Lot No. _____, Recorded Plat _____
 5. Private Claims _____

	A	B	C	D	E	F	G	H	I	J	K	L	M
1													
2	6	5	4	3	2	1							
3													
4	7	8	9	10	11	12							
5													
6	18	17	16	15	14	13							
7													
8	19	20	21	22	23	24							
9													
10	30	29	28	27	26	25							
11													
12	31	32	33	34	35	36							
13													

I, James J. Keller, in a field survey on April 20, 1991 do hereby certify that under requirements of P.A. 74, Michigan P.A. of 1970, the corner points mentioned in lines 1 and 2 above were in conformance with regulations and rules therefore as required in the current manual of survey instructions of the United States Department of the Interior, Bureau of Land Management or by a decree of a Court of Law and/or that the corner points mentioned in lines 3, 4 and 5 above were in conformance with the rules of the Michigan Board of Land Surveyors or by a Decree of a Court of Law; established, re-established, monumented, re-monumented, recovered, found as expressed below:

NOTE: Not more than 4 corners, all in the same town and range, may be recorded on this certificate.

A. Description of original monument and accessories and/or subsequent restoration:

Nov. 29, 1837, Abner E. VanNess, GLO "Set Post Corner to Sections 26, 27, 34 & 35"
 24" Beech S80°W 13 Links = 8.58'
 6" Beech S81°E 35 Links = 23.10'

Nov. 3, 1975, Douglas W. Booth RLS #7966, MDOT "Found 1-1/2" Iron Bar 24" (LCRC Liber 1, Page 252)
 32" Tri. Ash N80°E 31.70'
 7" Maple S33°E 42.08'
 8" Maple S86°W 42.42'

B. Description of corner evidence found and/or method applied in restoring or reestablishing corner:

April 20, 1991, James J. Keller #10693 "1-1/2"x24" Iron Not Found, Reset 1" Round IP and Cap by 3 Witness Nails"
 Found MSHD Tag in Tri Ash N88°E 31.70'
 Found Tag on ground Chopped tree to expose Nail set 30d at same distance 10" Maple S28°E 42.08'
 Chopped tree to expose Nail Tag not found set 30d 8" Maple S30°W 81.29'
 Found Nail 8" Maple S86°W 42.42'


Note: Road Grade appears to have been lowered here.

APPROVED BY MECOSTA CO. PEER GROUP
 IN ACCORDANCE WITH P.A. 343 of 1990

James S. Knapp
 CHAIRMAN
 DATE APRIL 15, 1996

C. Description of monument for corner and accessories established to perpetuate locating the position of the corner:

Set Remonumentation Monument and is accepted as careful perpetuation of the location of the Original Monument.
 Set 60d and tag S Side 10" Maple S87°W 42.43'
 Set 60d and tag S Side 10" Tri Ash N88°E 32.69'
 Set 60d and tag SW Side 10" Maple S29°E 42.08'
 Set 60d and tag SE Side 10" Walnut S30°W 81.47'

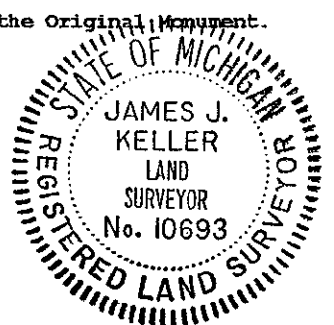

Signed by James J. Keller Date July 1, 1996

Surveyor's Michigan License No. 10693

July 1 1996

