

NOV 18 1997

COMMISSION

MECOSTA COUNTY REMONUMENTATION PROGRAM

CORNER APPROVED BY PEER GROUP ON August 8, 1997

LAND CORNER RECORDATION CERTIFICATE

Filing Requirement of Act 74, Mich. P.A. 1970

STATE OF MICHIGAN  
COUNTY OF MECOSTA  
RECEIVED FOR RECORD

For corners in

Mecosta  
(County)

Located in:

Corner Code #

Mecosta Twp.

97 SEP -5 P12:25

1. Public Land Survey	Sec. 2	T14N	R10W	J-1
		T	R	
		T	R	
		T	R	
2. Property Controlling in Section	S	T	R	
	S	T	R	
3. Miscellaneous Property in Sec.	S	T	R	
	S	T	R	

*James J. Keller*  
REGISTERED LAND SURVEYOR

Register of Deeds Stamp & File Number

4. Lot No. \_\_\_\_\_, Recorded Plat \_\_\_\_\_  
5. Private Claims \_\_\_\_\_

I, James J. Keller, in a field survey on Sept.-Oct. 1996, do hereby certify that under requirements of P.A. 74, Michigan P.A. of 1970, the corner points mentioned in lines 1 and 2 above were in conformance with regulations and rules therefore as required in the current manual of survey instructions of the United States Department of the Interior, Bureau of Land Management or by a decree of a Court of Law and/or that the corner points mentioned in lines 3, 4 and 5 above were in conformance with the rules of the Michigan Board of Land Surveyors or by a Decree of a Court of Law, established, re-established, monumented, re-monumented, recovered, found as expressed below.

NOTE: Not more than 4 corners, all in the same town and range, may be recorded on this certificate.

A. Description of original monument and accessories and/or subsequent restoration:

November 30, 1837, John Hodgson, Deputy Surveyor GLO, "Set Qr. Section Post" Section 35 Original Corner (J-1) not set

April 29-30, 1896 Lyman W. June, County Surveyor "Old Iron Corner"

June 13, 1973 Gerald J. Gray RLS #17741 (Survey L10 P189-190) "N 1/4 Corner"  
Nail 14" Maple N68°W 86.1' Nail 10" Maple N45°W 49.4' Nail 4" Wild Crab S03°E 53.1'

Circa 1975, Ferris students "Found 1" Iron rod, set mon box" (Believe this is Standard Corner, not Closing Corner)  
C/L 12 Mile Road 1.0' North Crabapple S10°E 53.15' 20" Maple N45°W 49.45'  
24" Maple N60°W 86.20'

May 16, 1979 Duane F. Wood RLS #24625 (Survey L10 P694) "Found 1" bar in mon box & set 1/2" rebar East 6.42"  
4" Crabapple S05°W 53.60' 20" Maple N45°W 54.31' 24" Maple N60°W 92.25'

July 7, 1987 James G. Knapp RLS #25853 (Survey L11 P230) "N 1/4 Corner Sec 2"  
Set rebar South 33.01' S 1/4 Corner Sec 35 N89°40'27"W 6.42'

B. Description of corner evidence found and/or method applied in restoring or reestablishing corner:

November 20, 1996 James J. Keller RLS #10693 Found 1/2" Rebar  
Found 30d NE side 26" Maple N44°W 54.61'  
Found 30d W side 5" Ash S08°W 47.30'  
Found 30d E side 36" Dead Maple N63°W 92.10  
Found 1" Iron in monument box West 6.39' = (Standard S 1/4 Cor Sec 35-15-10)


APPROVED BY MECOSTA CO. PEER GROUP  
IN ACCORDANCE WITH P.A. 345 of 1990

*James J. Knapp*  
CHAIRMAN  
DATE Aug. 8, 1997

C. Description of monument for corner and accessories established to perpetuate locating the position of the corner:

Accept 1/2" x 18" Rebar & set Remonumentation monument in box as best evidence of the position of the original corner.

Set 60d & tag E side 36" Dead Maple N63°W 92.12'  
Set 60d & tag NE side 26" Maple N44°W 54.61'  
Set PK nail & tag SW side P. Pole S42°E 194.18'  
Set 60d & tag W side 5" Ash S08°W 47.31'  
Set PK nail & tag NW side P. Pole S52°W 203.39'  
Found 1" Iron in monument box West 6.39' = (Standard S 1/4 Cor Sec 35-15-10)

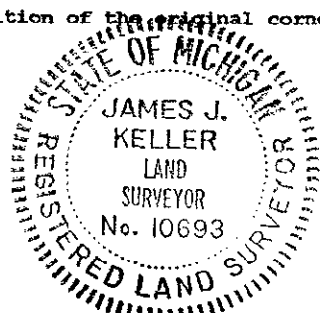

Signed by *James J. Keller* Date August 11, 1997

Surveyor's Michigan License No. 10693

54

SURVEY &  
REMONUMENTATION


NOV 18 1997

COMMISSION

JJK LJH

JUNE 9, 1997

as Found

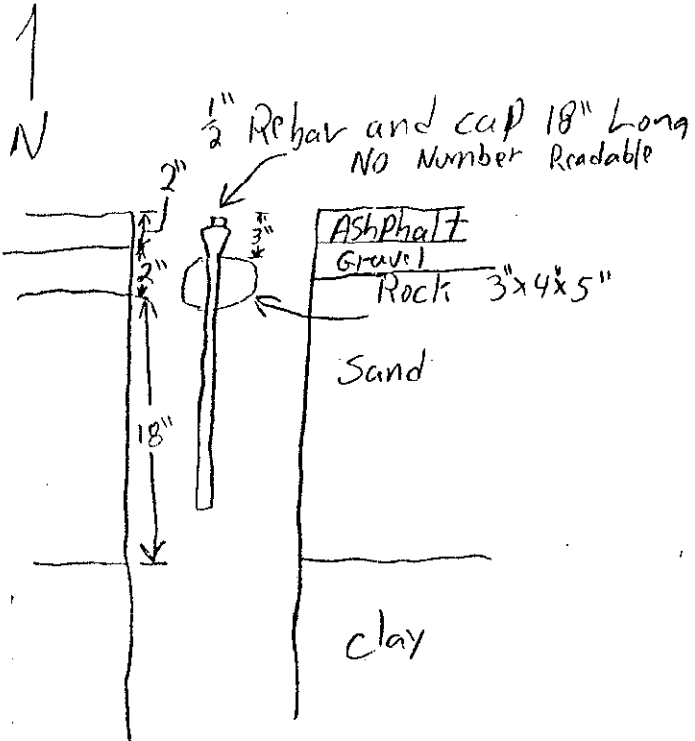

as Set

