

LAND CORNER RECORDATION CERTIFICATE
Filing Requirement of Act 74, Mich. P.A. 1970

For corners in
MECOSTA
 (County)

Located In: _____ Corner Code ~~##~~ _____

- | | | |
|------------------------------------|----------------------------|------------|
| 1. Public Land Survey | T <u>15W</u> R <u>9N</u> | <u>1-1</u> |
| | T _____ R _____ | _____ |
| | T _____ R _____ | _____ |
| | T _____ R _____ | _____ |
| 2. Property Controlling in Section | S <u>3</u> T _____ R _____ | <u>2,6</u> |
| | S _____ T _____ R _____ | _____ |
| 3. Miscellaneous Property in Sec. | S _____ T _____ R _____ | _____ |
| | S _____ T _____ R _____ | _____ |

Register of Deeds Stamp & File Number

4. Lot No. _____, Recorded Plat _____
5. Private Claims _____

A	B	C	D	E	F	G	H	I	J	K	L	M
2	6	5	4	3	2	1						
3												
4	7	8	9	10	11	12						
5												
6	18	17	16	15	14	13						
7												
8	19	20	21	22	23	24						
9												
10	30	29	28	27	26	25						
11												
12	31	32	33	34	35	36						
13												

I, CARL F. ROSER, in a field survey on DECEMBER 29, 19 88, do hereby certify that under requirements of P.A. 74, Michigan P.A. of 1970, the corner points mentioned in lines 1 and 2 above were in conformance with regulations and rules therefore as required in the current manual of survey instructions of the United States Department of the Interior, Bureau of Land Management or by a decree of a Court of Law and/or that the corner points mentioned in lines 3, 4 and 5 above were in conformance with the rules of the Michigan Board of Land Surveyors or by a Decree of a Court of Law; established, re-established, monumented, re-monumented, recovered, found as expressed below:

NOTE: Not more than 4 corners, all in the same town and range, may be recorded on this certificate.

A. Description of original monument and accessories and/or subsequent restoration:

1-1

2

6

6 (CONT)

B. Description of corner evidence found and/or method applied in restoring or reestablishing corner:

1-1

2

6

6 (CONT)

RECOV'D OLD 3" VIT TILE FOR NE COR S-3 FROM REMAINS OF 1 PINE WIT STP RECORDED BY CO SUR. W. WILLIT, 1919, CO SURVEY L.1, P.178. COR IS ON E EDGE OF OLD CONC COR FN POST (OLD FN'S E-W-S). NOTE: NE S-3 NOT SET IN 1838 OLD SURVEY (PAPER COR ONLY ON OLD PLAT); SEE COR RECORD I-2, E 1/4 COR S-3.

RESTORED NW COR NE 1/4-NE1/4 S-3 FROM FD REMAINS OF BOTH CO SURVEYOR W. WILLIT'S 1919 WIT STPS. COR IS VERY CLOSE TO A STRAIGHT LINE BTWN FD SEC CORNS AND FITS WILLIT'S DISTANCES VERY REASONABLE. RECORDED IN CO SUR L.1, P.178. COR IS ON LINE OF OLD E-W FN REMAINS LOOKING TO E 210'. COR IS IN 1 1/2" OF WATER & MUD IN TAMARACK AND ALDER SWP.

RESTORED NW COR SE 1/4-NE 1/4 S-3 FROM FD REMAINS OF BOTH CO SURVEYOR W. WILLIT'S 1919 WIT STPS. COR FALLS ON W EDGE OF OLD LEANING CED COR FN POST IN LINE W/OLD NOVEN WIRE FN TO E & S. COR POSITION IS REASONABLE FOR MIDWAY & ON LINE BETW FD OLD 1/8 COR TO N & S (WILLIT'S METHDD OF SUB'N OF NE 1/4 S-3). RECORDED IN CO SURVEY LIB, P.178. ALSO SEE

LINE FENCE AGREEMENT DATED 16 NOV., 1926 & RECORDED IN MISC. LIBER K, P.53 ON 15 JAN, 1927.

C. Description of monument for corner and accessories established to perpetuate locating the position of the corner:

1-1

2


6

6 (CONT)

FD 3" VIT TILE; ADDED 3/4"x20" IR ROD W/RLS CAP; ON E EDGE OF FD 6"x6"x15' CONC COR FN POST.
 3" R OAK N50°E 19.2'
 3" R OAK DUE E 23.2'
 3" R OAK DUE W 14.6'
 2" R OAK N45°W 9.2'
 CTR TRAIL DUE E 29'

PUSHED IN 5/8" X 10' GALV ROD W/RLS CAP & CED POST W/LOC TAG
 5" TAMARACK DUE N 15.0'
 4" TAMARACK N15°E 8.7'
 7" TAMARACK S60°E 12.5'
 5" TAMARACK S70°W 13.1'
 E EDGE SWP DUE E 280'±15'

DROVE 5/8" X 34" REROD W/RLS CAP; SET CED POST W/LOC TAG.
 4" MAPLE N55°E 14.9'
 5" ASH S50°E 29.6'
 2" ASH DUE S 14.6'
 CTR TRAIL DUE N 70'

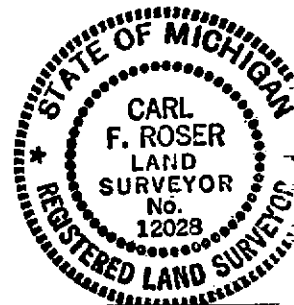

Signed by Carl F. Roser 03-09-89 Date _____

Surveyor's Michigan License No. 12028