LAND CORNER RECORDATION CERTIFICATE

Filing Requirement of Act 74, Mich. P.A. 1970

For corners in
MECOSTA
(County)

	Located In:	Corner Code ##
1. Public Land Survey	T 15N R 09W	G-1
	T ___ R ___	
	T ___ R ___	
	T ___ R ___	
2. Property Controlling	S 3 T ___ R ___	5
in Section	S ___ T ___ R ___	
3. Miscellaneous	S ___ T ___ R ___	
Property in Sec.	S ___ T ___ R ___	

Register of Deeds Stamp & File Number

4. Lot No. _____ , Recorded Plat _____
5. Private Claims _____

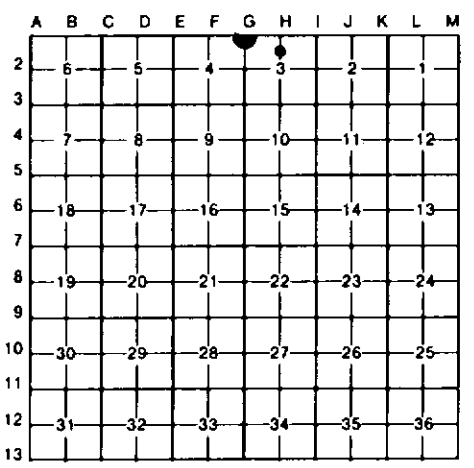

I, CARL F. ROSER, in a field survey on DECEMBER 29, 19 88, do hereby certify that under requirements of P.A. 74, Michigan P.A. of 1970, the corner points mentioned in lines 1 and 2 above were in conformance with regulations and rules therefore as required in the current manual of survey instructions of the United States Department of the Interior, Bureau of Land Management or by a decree of a Court of Law and/or that the corner points mentioned in lines 3, 4 and 5 above were in conformance with the rules of the Michigan Board of Land Surveyors or by a Decree of a Court of Law; established, re-established, monumented, re-monumented, recovered, found as expressed below:

NOTE: Not more than 4 corners, all in the same town and range, may be recorded on this certificate.

A. Description of original monument and accessories and/or subsequent restoration:

G-1

RECOV'D OLD 1/2" IR IN TILE FOR NW COR S-3. COR IS CO SUR L.W.JUNE 1895 & W.WILLITS 1919 COR OF REC. FD OLD FN COR ON GRD (W/FN REMAINS E & S) IS 33'S & 33'E. L.W.JUNE HAD ORIG COR(ONE B.T. DOWN & BURNT -ONE B.T. STP). W.WILLITS HAD ONE OF L.W.JUNES W.B.T'S & SAYS "TILE". GLO, NOTES & PLAT ARE NOT CLEAR IF THIS IS A CLOSING COR AT STD COR OR IF A

G-1(CONT)

JOG AT CLOSING COR. A.E.VANNESS (FEB 1838-GLO) SAYS "W BET 3 & 4; 74.30 INTERSECT N BDRY; SET POST COR TO 3 & 4 W/HEM B.T'S SE & SW". GLO PLAT RUNOUT ACREAGE ON N 1/4 OF SEC'S 1-2-3; CALC TO 80.00; 160.00, 240.00 CHS W OF COR TO T15&16N-R8&9W; LINES N. BET 1 & 2 AND 2 & 3 "NOT RUN". NEED TO CK FIELD NOTES IN ARCHIVES IN LANS TO SHED LIGHT ON THIS.

5

REESTAB'D SW COR N 1/2-NE 1/4 S-3; MIDWAY & ON LINE (THIS FITS CO SURVEYOR W.WILLITS SUBDIVISION METHOD OF NE 1/4 S-3) BETN CTR SEC & N 1/4 COR. THE N 1/4 COR CALC SINGLE PROPORTION FALLS IN LK. COR FALLS IN OLD N-S WOVEN WIRE FN. - DID NOT FIND ANY CONCLUSIVE EVIDENCE OF WILLITS COR RECORDED IN CO SURVEY L.1,P.178. SEE LINE

5 (CONT)

FENCE AGREEMENT, MISC LIB K, P.53, FOR KEY DESCRIPTION IN CHAIN OF TITLE THAT CONTROLS UNUSUAL METHOD OF SUBDIVIDING NE 1/4 OF S-3.

B. Description of corner evidence found and/or method applied in restoring or reestablishing corner:

G-1

FD 1/2" IR ROLD IN 3 VIT TILE; ADDED CED POST W/LOC TAG.

8" MAPLE	N35°W	53.3'
*16" W OAK	N10°E	48.5'
8" MAPLE	S80°E	13.9'
2" R OAK	S65°W	6.4'
CROOKED E-W TRL RD	DUE S	35'

* W.WILLIT'S 1919 B.T.

G-1(CONT)

5

DROVE 5/8" X 34" REROD W/RLS CAP; SET CED POST W/LOC TAG

6"X6"X5' CONC FN POST	S10°E	4.0'
6"X6"X5' CONC FN POST	SOUTH	62.5'
10" W PINE	S75°E	95.7'
4" CHERRY	S10°W	44.9'
S EDGE MARSH & LK	DUE N	50'±15'

5 (CONT)

STATE OF MICHIGAN
CARL F. ROSER
LAND SURVEYOR
No. 12028
REGISTERED LAND SURVEYOR

Signed by Carl F. Roser 03-09-89 Date _____

Surveyor's Michigan License No. 12028

FORM APPROVED BY MICHIGAN STATE BOARD OF LAND SURVEYORS, JAN. 28, 1971
REVISED MAY 14, 1975
REVISED JAN., 1983