LAND CORNER RECORDATION CERTIFICATE

Filing Requirement of Act 74, Mich. P.A. 1970

For corners in
MECOSTA
(County)

	Located In:	Corner Code ##
1. Public Land Survey	T 15N R 9W	I-1
	T ____ R ____	
	T ____ R ____	
	T ____ R ____	
2. Property Controlling	S 3 T ____ R ____	2,6
in Section	S ____ T ____ R ____	
3. Miscellaneous	S ____ T ____ R ____	
Property in Sec.	S ____ T ____ R ____	

Register of Deeds Stamp & File Number

4. Lot No. _____ , Recorded Plat _____
5. Private Claims _____

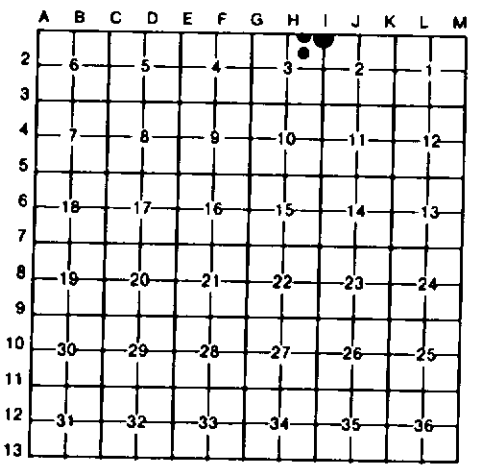

I, CARL F. ROSER, in a field survey on DECEMBER 29, 19 88, do hereby certify that under requirements of P.A. 74, Michigan P.A. of 1970, the corner points mentioned in lines 1 and 2 above were in conformance with regulations and rules therefore as required in the current manual of survey instructions of the United States Department of the Interior, Bureau of Land Management or by a decree of a Court of Law and/or that the corner points mentioned in lines 3, 4 and 5 above were in conformance with the rules of the Michigan Board of Land Surveyors or by a Decree of a Court of Law; established, re-established, monumented, re-monumented, recovered, found as expressed below:

NOTE: Not more than 4 corners, all in the same town and range, may be recorded on this certificate.

A. Description of original monument and accessories and/or subsequent restoration:

I-1	2	6	6 (CONT)
RECOV'D OLD 3" VIT TILE FOR NE COR S-3 FROM REMAINS OF 1 PINE WIT STP RECORDED BY CO SUR. W. WILLIT, 1919, CO SURVEY L.1, P.178. COR IS ON E EDGE OF OLD CONC COR FN POST (OLD FN'S E-W-S). NOTE: NE S-3 NOT SET IN 1838 GLO SURVEY (PAPER COR ONLY ON GLO PLAT); SEE COR RECORD I-2, E 1/4 COR S-3.	RESTORED NW COR NE 1/4-NE1/4 S-3 FROM FD REMAINS OF BOTH COSURVEYOR W. WILLIT'S 1919 WIT STPS. COR IS VERY CLOSE TO A STRAIGHT LINE BTWN FD SEC CORS AND FITS WILLITS DISTANCES VERY REASONABLE. RECORDED IN CO SUR L.1, P.178. COR IS ON LINE OF OLD E-W FN REMAINS LOOKING TO E 210'. COR IS IN 1 1/2" OF WATER & MUD IN TAMARACK AND ALDER SWP.	RESTORED NW COR SE 1/4-NE 1/4 S-3 FROM FD REMAINS OF BOTH CO SURVEOYR W.WILLIT'S 1919 WIT STPS. COR FALLS ON N EDGE OF OLD LEANING CED COR FN POST IN LINE W/OLD WOVEN WIRE FN TO E & S. COR POSITION IS REASONABLE FOR MIDWAY & ON LINE BETW FD OLD 1/8 COR TO N & S (WILLIT'S METHOD OF SUB'N OF NE 1/4 S-3). RECORDED IN CO SURVEY LIB, P.178. ALSO SEE	LINE FENCE AGREEMENT DATED 16 NOV., 1926 & RECORDED IN MISC. LIBER K, P.53 ON 15 JAN, 1927.

B. Description of corner evidence found and/or method applied in restoring or reestablishing corner:



C. Description of monument for corner and accessories established to perpetuate locating the position of the corner:

I-1	2	6	6 (CONT)
FD 3" VIT TILE; ADDED 3/4"X20" IR ROD W/RLS CAP; ON E EDGE OF FD 6"X6"X5' CONC COR FN POST.	PUSHED IN 5/8" X 10' GALV ROD W/RLS CAP & CED POST W/LOC TAG	DROVE 5/8" X 34" REROD W/RLS CAP; SET CED POST W/LOC TAG.	
3" R OAK N50°E 19.2'	5" TAMARACK DUE N 15.0'	4" MAPLE N55°E 14.9'	
3" R OAK DUE E 23.2'	4" TAMARACK N15°E 8.7'	5" ASH S50°E 29.6'	
3" R OAK DUE W 14.6'	7" TAMARACK S60°E 12.5'	2" ASH DUE S 14.6'	
2" R OAK N45°W 9.2'	5" TAMARACK S70°W 13.1'	CTR TRAIL DUE N 70'	
CTR TRAIL DUE E 29'	E EDGE SWP DUE E 280'±15'		

STATE OF MICHIGAN
CARL F. ROSER
LAND SURVEYOR
No. 12028
REGISTERED LAND SURVEYOR

Signed by Carl F. Roser 03-09-89 Date _____

Surveyor's Michigan License No. 12028

FORM APPROVED BY MICHIGAN STATE BOARD OF LAND SURVEYORS, JAN. 28, 1971
REVISED MAY 14, 1975
REVISED JAN., 1983