LAND CORNER RECORDATION CERTIFICATE

Filing Requirement of Act 74, Mich. P.A. 1970

For corners in
MECOSTA
(County)

	Located In:	Corner Code ##
1. Public Land Survey	T 15N R 9W	6-2
	T ____ R ____	
	T ____ R ____	
	T ____ R ____	
2. Property Controlling	S 3 T ____ R ____	8
in Section	S ____ T ____ R ____	
3. Miscellaneous	S 3 T ____ R ____	* 1016 W OF
Property in Sec.	S ____ T ____ R ____	H-2.

Register of Deeds Stamp & File Number

4. Lot No. _____ , Recorded Plat _____
5. Private Claims _____

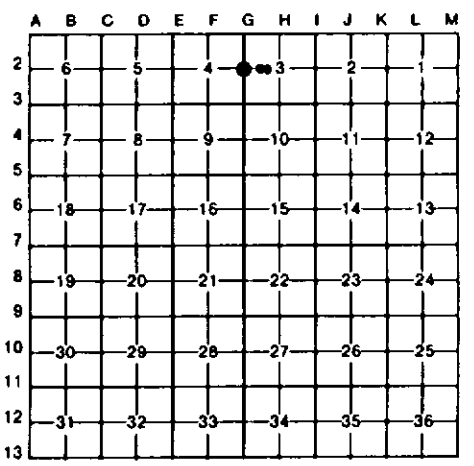

I, CARL F. ROSER , in a field survey on DECEMBER 29, , 19 89 , do hereby certify that under requirements of P.A. 74, Michigan P.A. of 1970, the corner points mentioned in lines 1 and 2 above were in conformance with regulations and rules therefore as required in the current manual of survey instructions of the United States Department of the Interior, Bureau of Land Management or by a decree of a Court of Law and/or that the corner points mentioned in lines 3, 4 and 5 above were in conformance with the rules of the Michigan Board of Land Surveyors or by a Decree of a Court of Law; established, re-established, monumented, re-monumented, recovered, found as expressed below:

NOTE: Not more than 4 corners, all in the same town and range, may be recorded on this certificate.

A. Description of original monument and accessories and/or subsequent restoration:

6-2

8

B. Description of corner evidence found and/or method applied in restoring or reestablishing corner:

6-2

RECOV'D OLD IR IN TILE FOR W 1/4 S-3. COR IS CO SURVEYOR L.W.JUNE, 1895 & CO SURVEYOR W.WILLITS, 1919 COR OF RECORD. FD BOTH WILLITS WITS. FD 2 RLS GEO. BLASS BT'S. FD OLD FN REMAINS (E & W) IS 36'±3'E & 5'±2' N OF TILE. L.W.JUNE SAYS ORIG COR. ONE OF WILLITS B.T'S IS L.W.JUNE'S W.B.T.

8

RECOVERED AND ACCEPTED OLD REROD FOR NE COR, NW 1/4-SW 1/4, S-3. FD REMAINS OF 1 CO SURVEYOR W.WILLITS 1919 PINE WIT STP. FIND WILLITS SURVEY RECORDED IN CO SURVEY L.1, P.178. RLS G.BLASS USED THIS COR IN 1964 IN HIS SURVEY FOR A.SAKMAR.

*

FD 3/4" X 18" "T" IR. W/RLS CAP (GEO. BLASS) FOR NE COR OF STATE OWNED W 20 ACRES OF E 1/2 OF SW 1/4 OF S-3; SEE WARRANTY DEED, L.243,P.420, DATED 18 DEC., 1952. SEE BLASS SUR FOR A SAKMAR DATED JUNE 1964. ALSO SEE CERT. OF SURVEYS; L.10, P.152; L.10, P.157; L.10,P.269; L.10,P.324. THE CTR OF S-3 (H-2) IS S87°56'33'E, 1016.49'.

* (CONT.)

ALSO SEE REF. QUIT CLAIM DEED, L.299, P.315, DATED 8 AUG,1952

C. Description of monument for corner and accessories established to perpetuate locating the position of the corner:

6-2

FD 1/2" IR ROD IN 3" VIT TILE; ADDED CED POST W/LOC TAG.

6" R OAK	N30°W	14.5'
3" R OAK	N55°E	28 7'
12 PINE STP	S65°E	25.2'
4" R OAK	DUE W	15.8'
NE EDGE MARSH	DUE S	212'±2'
CTR N-S TR RD	EAST	913'±
SET CED POST W/ LOC TAG	S87°57'E	13.5CH.

8

FD OLD 1/2" REROD; ADDED RLS CAP AND CED POST W/LOC TAG.

OLD 13" N PINE STUMP	N10°E	23.4'
2" MAPLE	N35°E	6.9'
2" MAPLE	S60°E	9.2'
11" AM BEECH	N75°W	21.4'

*

FD 3/4" X 18" "T" IR W/RLS CAP IN BOTTOM W SIDE OF POTHOLE; ADDED CED POST.

4" MAPL(CLP 3)	N60°W	35.3'
9" B CHERRY BEHIND OLD 30"± W PINE STP	DUE N	49.9'
3" MAPLE	S50°W	32.9'

Signed by Carl F. Roser 03-09-89 Date _____

Surveyor's Michigan License No. 12028

STATE OF MICHIGAN
CARL F. ROSER
LAND SURVEYOR
No. 12028
REGISTERED LAND SURVEYOR

FORM APPROVED BY MICHIGAN STATE BOARD OF LAND SURVEYORS, JAN. 28, 1971
REVISED MAY 14, 1975
REVISED JAN., 1983