LAND CORNER RECORDATION CERTIFICATE
Filing Requirement of Act 74, Mich. P.A. 1970

For corners in
NECOSTA
(County)

	Located In:	Corner Code ##
1. Public Land Survey	T 15N R 9W	1-3
	T ___ R ___	
	T ___ R ___	
	T ___ R ___	
2. Property Controlling	S 3 T ___ R ___	14
in Section	S ___ T ___ R ___	
3. Miscellaneous	S ___ T ___ R ___	
Property in Sec.	S ___ T ___ R ___	

Register of Deeds Stamp & File Number

4. Lot No. _____ , Recorded Plat _____
5. Private Claims _____

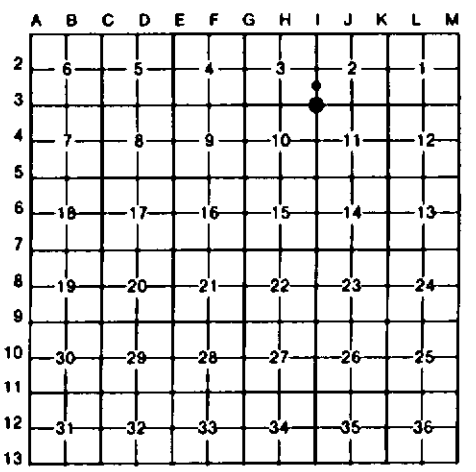

I, CARL F. ROSER, in a field survey on DECEMBER 29, 19 88, do hereby certify that under requirements of P.A. 74, Michigan P.A. of 1970, the corner points mentioned in lines 1 and 2 above were in conformance with regulations and rules therefore as required in the current manual of survey instructions of the United States Department of the Interior, Bureau of Land Management or by a decree of a Court of Law and/or that the corner points mentioned in lines 3, 4 and 5 above were in conformance with the rules of the Michigan Board of Land Surveyors or by a Decree of a Court of Law; established, re-established, monumented, re-monumented, recovered, found as expressed below:

NOTE: Not more than 4 corners, all in the same town and range, may be recorded on this certificate.

A. Description of original monument and accessories and/or subsequent restoration:

1-3
I-3(CONT)
14
14 (CONT)

B. Description of corner evidence found and/or method applied in restoring or reestablishing corner:

1-3
FD OLD 1/2" IR ROD IN 3" VIT TILE FOR SE COR S-3; PIECES OF TOP TILE, 2ND TILE INTACT. COR FALLS 2' S OF CTR E-W GRVL RD. OLD ST FN POST IR IS 7.1'±E & 0.2'± N.OF ROD IN TILE. TILE(IR) OF RECORD BY CO. SURVEYOR L.N.JUNE, NW COR S-11, DATED APR.1902, CO SUR'S LIBER, PG.104 AND L.N.JUNE RETRACEMENT SUR OF ENTIRE TWP, 1895, CO SUR'S LIBER, PG.281.

I-3(CONT)
ALSO SE COR S-3 (TILE & IR) TO SW COR S-3 (FD IR), FITS MEA. OF S LINE S-3; 5351.70' THIS SUR, 5352.0' BY CO SUR WALTER WILLITS, FEB. 1919, SUR & SEC SUB'N OF S-3, CO SUR. LIBER, PG.178. IR IN TILE ALSO FD, USED & WIT. BY RLS, CLINT COLE. ALSO SEE SUR FILE, SUR MAP & REPORT. P.A.S.854-8, HILLSVIEW LK.

14
ESTAB'D SE COR NE 1/4, SE 1/4 S-3; PER STD BLM INSTRUCTIONS. COR FITS CO SURVEYOR W.WILLITS DISTANCES TO 1/4 COR N, SEC COR S REASONABLE; AND VERY REASONABLY TO FD OLD CTR OF SE 1/4; RECORDED IN CO SURVEY L.1, PG.178. COR IS IN LINE W/FD FN REMAINS ON GND N'LY LOOKING N 111' ON HIGH GND. DROVE REROD N89°15'W 16.50' FOR NW COR OF E 1 ROD OF

14 (CONT)
SE 1/4,SE 1/4, S-3 (RIGHTS OF INGRESS AND EGRESS ACROSS SAID E 1 ROD). SEE RIGHT OF WAY EASEMENT RECORDED IN L.284, PG.53 AND WARRANTY DEED RECORDED IN L.284, PG.57.

C. Description of monument for corner and accessories established to perpetuate locating the position of the corner:

1-3
FD OLD 1/2" IR ROD IN 3" VIT TILE.
DR 5/8"X34" REROD W/RLS CAP & SET CED POST N26°23'W 36.67'
DR 5/8"X34" REROD W/RLS CAP & SET CED POST N00°20'E 33.00'
MAPLE CLP OF 8-2"TO 5" N10°E 57.88'
GW COR 5'X5' CONC WELL PIT N45°E 56.6'

I-3(CONT)
24" MAPLE N70°E 68.88'
FD 1/2" IR ROD W/RLS CAP S01°49'E 32.9'

14
DR 1" X 5' GALV PIPE W/RLS CAP; SET CED POST W/LOC TAG.
3" MAPLE N80°E 34.7'
3" MAPLE S70°E 50.2'
3" TW W BIRCH S15°W 33.2'
3" MAPLE S75°W 33.6'
E EDGE MARSH DUE E 52'±4'
N EDGE MARSH DUE N 111'±4'
DROVE 5/8"X34" REROD W/LS CAP & SET CED POST. N89°15'W 16.50

14 (CONT)

STATE OF MICHIGAN
CARL F. ROSER
LAND SURVEYOR
No. 12028
REGISTERED LAND SURVEYOR

Signed by Carl F. Roser 03-09-89 Date _____

Surveyor's Michigan License No. 12028

FORM APPROVED BY MICHIGAN STATE BOARD OF LAND SURVEYORS, JAN. 28, 1971
REVISED MAY 14, 1975
REVISED JAN., 1983