LAND CORNER RECORDATION CERTIFICATE

Filing Requirement of Act 74, Mich. P.A. 1970

For corners in
MECOSTA
(County)

	Located In:	Corner Code #1
1. Public Land Survey	T 15N R 9W	I-2
	T ___ R ___	
	T ___ R ___	
	T ___ R ___	
2. Property Controlling	S 3 T ___ R ___	13
in Section	S ___ T ___ R ___	
3. Miscellaneous	S ___ T ___ R ___	
Property in Sec.	S ___ T ___ R ___	

Register of Deeds Stamp & File Number

4. Lot No. _____ , Recorded Plat _____
5. Private Claims _____

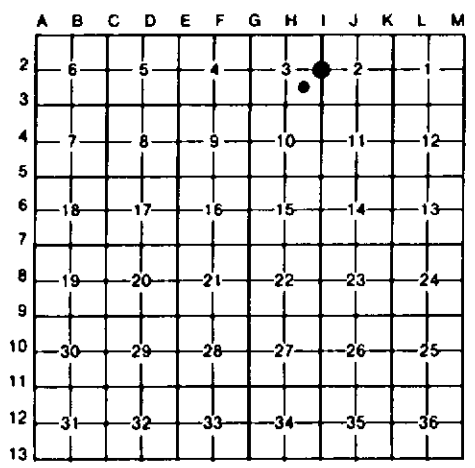

I, CARL F. ROSER, in a field survey on DECEMBER 29, 19 88, do hereby certify that under requirements of P.A. 74, Michigan P.A. of 1970, the corner points mentioned in lines 1 and 2 above were in conformance with regulations and rules therefore as required in the current manual of survey instructions of the United States Department of the Interior, Bureau of Land Management or by a decree of a Court of Law and/or that the corner points mentioned in lines 3, 4 and 5 above were in conformance with the rules of the Michigan Board of Land Surveyors or by a Decree of a Court of Law; established, re-established, monumented, re-monumented, recovered, found as expressed below:

NOTE: Not more than 4 corners, all in the same town and range, may be recorded on this certificate.

A. Description of original monument and accessories and/or subsequent restoration:

I-2

I-2 (CONT)

13

13 (CONT)

B. Description of corner evidence found and/or method applied in restoring or reestablishing corner:

I-2

RESTORED E 1/4 COR S-3. FROM FD BOTH CO. SURVEYOR W.WILLITS PINE STP WITS. THE STP SE HAS PART OF 3 OLD AXE NOTCHES. THE GLO SURVEY DID NOT SET THIS COR BECAUSE OF "IMPASSABLE TAMARACK SWP" AT 18 CH. N OF SE S-3. FIND W.WILLITS 1919 SUR RECORDED AT REGISTER OF DEEDS IN LG, WHITE CO SURVEYOR'S RECORD (LIBER) 1, PG.178. WILLITS NOTES

I-2 (CONT)

INDICATE HE ACCEPTED EXISTING CO FN POST. OLD CROOKED N-S WIRE IN TREES IS E, 6'±3'. OLD WIRE E'LY IN TREES IS S, 3'±3'.

13

FD & ACCEPTED 2" X 4' PIPE FOR SW COR NE 1/4-SE 1/4 OF S-3. PIPE IS BELIEVED TO BE RESULT OF W.WILLITS SUR & SEC. SUB'N OF S-3 IN 1919, CO. SUR. LIBER 1, P.178 AND ADDITIONAL WORK BY E.E.SOURS IN 1925, CO. SUR. LIBER 1, P.202. PIPE IS 1 FT E OF NEWER N-S W-W FN; NO E-W FN EVIDENT. COULD NOT LOCATE ANY OF W.W. 1919 WITS. SOURS SAYS "SET IRON FROM WILLET'S

13 (CONT)

BEARING STUMPS".

C. Description of monument for corner and accessories established to perpetuate locating the position of the corner:

I-2

SET DNR MON & CED POST.

13" W OAK	S15°E	35.0'
9" MAPLE	S75°W	20.1'
14" W OAK	N70°W	15.4'
11" MAPLE(CLP 3)	N40°E	10.3'

I-2 (CONT)

13

FD 2"X4' GALV PIPE W/COUPLING; ADDED CED POST W/LOC TAG.

14" W PINE	N30°W	20.88
12" W PINE	S05°W	21.48
NE COR NEW SHOWER BLDG ON CONC SLAB	S85°W	119.5'

13 (CONT)

STATE OF MICHIGAN
CARL F. ROSER
LAND SURVEYOR
No. 12028
REGISTERED LAND SURVEYOR

Signed by Carl F. Roser 03-09-89 Date _____

Surveyor's Michigan License No. 12028

FORM APPROVED BY MICHIGAN STATE BOARD OF LAND SURVEYORS, JAN. 28, 1971
REVISED MAY 14, 1975
REVISED JAN., 1983