

FEB 26 1998

**MECOSTA COUNTY REMONUMENTATION PROGRAM**

CORNER APPROVED BY PEER GROUP ON December 12, 1997

SECTION

**LAND CORNER RECORDATION CERTIFICATE**

Filing Requirement of Act 74, Mich. P.A. 1970

STATE OF MICHIGAN  
COUNTY OF MECOSTA  
RECEIVED FOR RECORD

For corners in	Located In:	Corner Code #
<u>MECOSTA</u> (County)		
1. Public Land Survey	T 15N R 9W	A-08
	T R	
	T R	
	T R	
2. Property Controlling in Section	S T R	
	S T R	
3. Miscellaneous Property in Sec.	S T R	
	S T R	

'97 DEC 29 A10:06

*James Brown*  
REGISTER OF DEEDS

Register of Deeds Stamp & File Number

4 Lot No. \_\_\_\_\_, Recorded Plat \_\_\_\_\_  
5. Private Claims \_\_\_\_\_

	A	B	C	D	E	F	G	H	I	J	K	L	M
1													
2	6	5	4	3	2	1							
3													
4	7	8	9	10	11	12							
5													
6	18	17	16	15	14	13							
7													
8	19	20	21	22	23	24							
9													
10	30	29	28	27	26	25							
11													
12	31	32	33	34	35	36							
13													

I, Thomas H. Sage, in a field survey on November 26, 1997, do hereby certify that under requirements of P.A. 74, Michigan P.A. of 1970, the corner points mentioned in lines 1 and 2 above were in conformance with regulations and rules therefore as required in the current manual of survey instructions of the United States Department of the Interior, Bureau of Land Management or by a decree of a Court of Law and/or that the corner points mentioned in lines 3, 4 and 5 above were in conformance with the rules of the Michigan Board of Land Surveyors or by a Decree of a Court of Law; established, re-established, monumented, re-monumented, recovered, found as expressed below:

NOTE: Only one corner may be recorded on this certificate.

A. Description of original monument and accessories and/or subsequent restoration:

G.L.O. Vol. 2, Pg. 98 & 276 ( Sept. 25, 1986 ) Duane Wood, PS#24625 Corner is shown on Plot of Pine Forest Subdivision  
Pine 12 for 1/4 Sec. Post L.C.R.C.: L. 2, Pg. 131  
Found 1" Steel Bar: ( May 1986 ) Henry Mulder, PS#25862  
8" Pine, N18°E, 102.83' Fnd. 3/4" Shaft:  
5" Pine, S60°W, 17.10' 6" W. Pine, N7°E, 34.54'  
6" Pine, S55°E, 42.0' 5" W. Pine, N45°W, 49.90'  
18" W. Pine, S60°W, 17.05'  
8" W. Pine, S45°E, 163.57'

( 1895 ) Co. Surveyor  
Co. Surveyor Book, Pg. 282  
Pine Stump for Corner:  
Poplar 6, W. 6Lks.

**Duane Wood Rec'd Surveys:**  
All have identical wit. As L.C.R.C.: L. 2, Pg. 131  
12-13-78; L. 10, Pg. 690  
9-20-79; L. 10, Pg. 799  
2-9-94; L. 11, Pg. 894  
10-1-96; L. 12, Pg. 112

( 14 Oct 1996 ) Thomas Sage, PS#33139  
Found 1 1/2" Axle Shaft: Set nail & tag at following:  
N. face, 24" W. Pine, S60°W, 17.05' ( old nail missing )  
N. face, 18" W. Pine, S80°W, 43.80'  
E. face, 12" R. Oak, N10°W, 105.55'  
E. face, 12" R. Pine, N7°E, 34.50' ( above old nail )

B. Description of corner evidence found and/or method applied in restoring or reestablishing corner:

- Upon excavating and further investigation I discovered that what I had previously called an "axle shaft" was a 1" Pipe with a 3/4" iron bar inside.
- All accessories were present as left on 14 Oct 1996.
- Accepted position of Pipe and Iron bar as best evidence of the perpetuation of corner.

C. Description of monument for corner and accessories established to perpetuate locating the position of the corner:


- ( 17 Dec 97 ) Replaced Pipe and Iron bar with Mecosta County Remonumentation Monument. ( Pipe and Bar left inside of Monument )
  - On South edge of Two-Track, East/West; On West edge of Two-Track, North/South
  - Found Nail & Tag #33139, N. face, 24" W. Pine, S60°W, 17.05'
  - Found Nail & Tag #33139, N. face, 18" W. Pine, S80°W, 43.80'
  - Found Nail & Tag #33139, E. face, 12" R. Oak, N10°W, 105.55'
  - Found Nail & Tag #33139, E. face, 12" R. Pine, N7°E, 34.50' ( above old nail )
  - Set Nail & Remon. Tag, W. Face, 12" Red Pine, N5°E, 42.60'
- Monument is accepted as a careful and faithful perpetuation of the position of the original corner.

APPROVED BY MECOSTA CO. PEER GROUP  
IN ACCORDANCE WITH P.A. 345 of 1990  
*James G. Knapp*  
CHAIRMAN  
DATE DEC. 12, 1997

Signed by Thomas H. Sage

Date December 17, 1997

Surveyor's Michigan License No. 33139

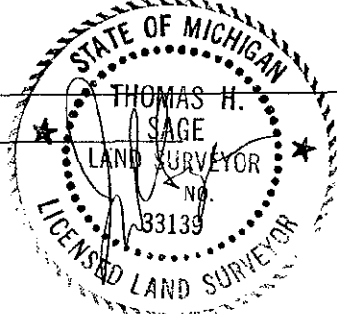

FORM APPROVED BY MICHIGAN STATE BOARD OF LAND SURVEYORS, JAN. 28, 1971  
REVISED MAY 14, 1975  
REVISED JAN., 1983  
ADAPTED FOR WORD PROCESSING MARCH, 1993