

**SURVEY & REMONUMENTATION**

MAR 14 2000

**LAND CORNER RECORDATION CERTIFICATE**  
Filing Requirement of Act 74, Mich. P.A. 1970

STATE OF MICHIGAN  
COUNTY OF MECOSTA  
RECEIVED FOR RECORD

**SECTION**

For corners in

<u>Mecosta</u> (County)	Located In:	Corner Code #
1. Public Land Survey	T <u>15</u> N R <u>09</u> W	<u>G-6</u>
	T _____ R _____	_____
	T _____ R _____	_____
	T _____ R _____	_____
2. Property Controlling in Section	S _____ T _____ R _____	_____
	S _____	_____
	T _____ R _____	_____
3. Miscellaneous	S _____	_____
	T _____ R _____	_____
Property in Sec.	S _____	_____
	T _____ R _____	_____

'99 DEC 14 P2:23

*Jozann Brown*  
REGISTER OF DEEDS

Register of Deeds Stamp & File Number

4. Lot No. \_\_\_\_\_, Recorded Plat \_\_\_\_\_

5. Private Claims \_\_\_\_\_

I, James H. Carter, in a field survey in November, 1999 do hereby state that under requirements of P.A. 74, Michigan P.A. of 1970, the corner points mentioned in lines 1 and 2 above were in conformance with regulations and rules therefore as required in the current manual of survey instructions of the United States Department of the Interior, Bureau of Land Management or by a decree of a Court of Law and /or that the corner points mentioned in lines 3, 4 and 5 above were in conformance with the rules of the Michigan Board of Land Surveyors or by a Decree of a Court of Law; established, re-established, monumented, recovered, found as expressed below:

	A	B	C	D	E	F	G	H	I	J	K	L	M
1													
2	6		5		4		3		2		1		
3													
4	7		8		9		10		11		12		
5													
6	18		17		16		15		14		13		
7													
8	19		20		21		22		23		24		
9													
10	30		29		28		27		26		25		
11													
12	31		32		33		34		35		36		
13													

**NOTE:** Not more than 1 corner, all in the same town and range, may be recorded on this certificate.

**A. Description of original monument and accessories and/or subsequent restoration:**

- Deputy surveyor set 1/4 sec post - Sugar 12 S 33 W 17 and Ironwood S 75 E 15
- 1895 - L. W. June - Sugar 12 S 33 E 17 OBT
- 1896 - L. W. June - Tile corner
- 1896 - L. W. June - Old field book shows distance from SW cor of section 15 to be 20.12 and 20.12 chains, Distance from center of sec 15 to be 20.72 and 20.72 chains.
- 1905 - L. W. June - tile corner
- Early 1900's - Old P. M. Rail Road ( now CSX ) plans call for tile.

**B. Description of corner evidence found and/or method applied in restoring or reestablishing corner:**


Computed location from June's resurvey of section 15 and section corners found at govt. half mile both North and South of W 1/4 cor of section 15

In field search at computed location found old E-W fence still standing and found old fence ( under ground surface) running North. Computed location is at the intersection of these two fences. Applied rule for lost corner and it fit physical evidence. Accepted this location as the true quarter corner position.

**C. Description of monument for corner and accessories established to perpetuate locating the position of the corner:**

G-6 - CORNER COMMON TO SECTIONS 15 AND 16, T 15 N, R09W.  
SET A STANDARD MECOSTA COUNTY REMONUMENTATION MONUMENT AND IS ACCEPTED AS A CAREFUL AND FAITHFUL RE-ESTABLISHMENT OF THE POSITION OF THE ORIGINAL CORNER.

N 48 E - 11.45' - NAIL & TAG IN 17" MAPLE  
N 10 E - 14.96' - NAIL & TAG IN 15" MAPLE  
WEST - 15.50' - NAIL & TAG IN 16" ASH  
S 72 W - 34.29' - NAIL & TAG IN 14" MAPLE

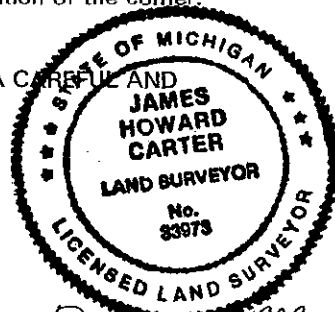

Signed by James H. Carter  
Surveyor's Michigan License No. 33973

Date DEC 15, 1999

APPROVED BY MECOSTA CO. PEER GROUP  
IN ACCORDANCE WITH P.A. 345 of 1990

James M. Knapp  
CHAIRMAN  
DATE DEC 3, 1999

FORM APPROVED BY MICHIGAN STATE BOARD OF PROFESSIONAL SURVEYORS