

SURVEY & REMONUMENTATION

MECOSTA COUNTY REMONUMENTATION PROGRAM

FEB 26 1998

CORNER APPROVED BY PEER GROUP ON 11-14-97

LAND CORNER RECORDATION CERTIFICATE

Filing Requirement of Act 74, Mich. P.A. 1970

SECTION
For Corners in

STATE OF MICHIGAN
COUNTY OF MECOSTA
RECEIVED FOR RECORD

Mecosta (County)	Located In:		Corner Code #
	T 15N	R 9W	G-07
	T	R	
	T	R	
1. Public Land Survey	T	R	
	S T	R	
	S T	R	
	S T	R	
	S T	R	

'97 DEC 29 10:06

James Brown
REGISTER OF DEEDS

- 2. Property controlling in Section
- 3. Miscellaneous Property in Sec.
- 4. Lot No. _____, Recorded Plat _____
- 5. Private Claims _____

Register of Deeds Stamp & File Number

I, James H. Carter, in a field survey on October 31, 1997 do hereby certify that under requirements of P.A. 74, Michigan P.A. of 1970, the corner points mentioned in lines 1 and 2 above were in conformance with regulations and rules therefore as required in the current manual of survey instructions of the United States Department of the Interior, Bureau of Land Management or by a decree of court law and/or that the corner points mentioned in lines 3, 4 and 5 above were in conformance with the rules of Michigan Board of Land Surveyors or by a decree of a court of law; established, re-established, monumented, re-monumented, recovered, found as expressed below:

	A	B	C	D	E	F	G	H	I	J	K	L	M
1													
2	6	5						3		2			1
3													
4	7	8						10		11			12
5													
6	18	17						15		14			13
7													
8	19	20						22		23			24
9													
10	30	29						27		26			25
11													
12	31	32						34		35			36
13													

NOTE: Only one corner may be recorded on this certificate.

A. Description of original monument and accessories and /or subsequent restoration:

- 1838 - JAN 29 - FEB 7, DEPUTY SURVEYOR, A. E. VAN NESS, SET POST. BEECH 12" - S 35 E - 32 LINKS, LYNN 18" - N 63 E - 15 LINKS.
- 1905 - L. W. JUNE - OLD TILE CORNER REPLACED
- 1930 - MECOSTA COUNTY, 16" OAK - SOUTHEAST - 39FT, TWP HALL - SOUTHWEST - 53FT.
- 1988 - LCRC L-2, P -228, GERALD J. GREY FOUND 1/2" IRON ROD 18" MAPLE - 67.2' - S 10 E, 36" OAK - 40.6' - S 45 E, TWIN 15" MAPLE - 40.90' - N 55 W.

APPROVED BY MECOSTA CO. PEER GROUP
IN ACCORDANCE WITH P.A. 345 of 1990

James H. Knapp
CHAIRMAN
DATE NOV. 14, 1997


B. Description of corner evidence found and/or method applied in restoring or reestablishing corner:

FOUND REROD WITH UNLEDGEABLE RLS CAP FLUSH WITH BIT SURFACE AND OVER LARGE STONE 2.8' BELOW SURFACE.
FOUND REROD WITH RLS CAP #17741 & #24625 SET ALONG SIDE OF STONE AND AT THE SAME DEPTH.
FOUND 35" OAK 39' SE OF CORNER AS PER COUNTY WITNESS. FOUND NAIL UNDER TREE BARK IN A 35" OAK - S 30 E - 40.66 FT.
FOUND NAIL IN 19" MAPLE - S 23 E - 67.16 FT.

SET MECOSTA COUNTY REMONUMENTATION MONUMENT OVER STONE AT THE POSITION OF THE SURFACE RLS REROD AND PLACED MONUMENT BOX.

C. Description of monument for corner and accessories established to perpetuate locating the position of the corner:

G-7 - CORNER COMMON TO SECTIONS 15, 16, 21 AND 22, T15N, R09W.
SET A STANDARD MECOSTA COUNTY REMONUMENTATION MONUMENT AND IS ACCEPTED AS A CAREFUL AND FAITHFUL REESTABLISHMENT OF THE POSITION OF THE ORIGINAL CORNER.
N 48 W - 41.01' - NAIL IN 13" MAPLE
N 02 E - 20.96' - NAIL IN 13" ASH
N 44 E - 31.89' - NAIL IN 15" ASH
S 30 E - 40.45' - NAIL IN 35" OAK
S 23 E - 67.16' - SPIKE IN 19" MAPLE
S 75 W - 114.14' - NAIL IN POWER POLE

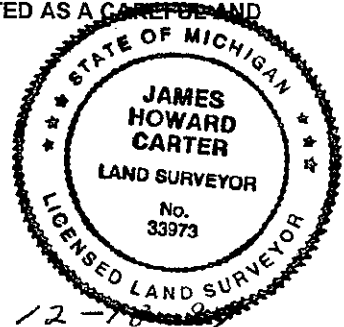

Signed by James H. Carter Date 12-1-97
Surveyor's Michigan License No. 33973