

SURVEY &
REMONUMENTATION

MECOSTA COUNTY REMONUMENTATION PROGRAM

MAY 05 1997 CORNER APPROVED BY PEER GROUP ON October 24, 1996

COMMISSION

LAND CORNER RECORDATION CERTIFICATE

Filing Requirement of Act 74, Mich. P.A. 1970

STATE OF MICHIGAN
COUNTY OF MECOSTA
RECEIVED FOR RECORD

For corners in <u>Mecosta</u> (County)	Located In: <u>Colfax Township</u>	Corner Code # <u>G-8</u>
1. Public Land Survey	SEC 21 T 15N R 09W	<u>G-8</u>
	T _____ R _____	_____
	T _____ R _____	_____
	T _____ R _____	_____
2. Property Controlling in Section	S _____ T _____ R _____	_____
	S _____ T _____ R _____	_____
3. Miscellaneous Property in Sec.	S _____ T _____ R _____	_____
	S _____ T _____ R _____	_____
4. Lot No. _____, Recorded Plat _____		
5. Private Claims _____		

'96 DEC 17 AM 11:31

Joanna Brown
REGISTER OF DEEDS

Register of Deeds Stamp & File Number

	A	B	C	D	E	F	G	H	I	J	K	L	M
1													
2	6	5	4	3	2	1							
3													
4	7	8	9	10	11	12							
5													
6	18	17	16	15	14	13							
7													
8	19	20	21	22	23	24							
9													
10	30	29	28	27	26	25							
11													
12	31	32	33	34	35	36							
13													

I, James J. Keller, in a field survey on June 27, 1996, do hereby certify that under requirements of P.A. 74, Michigan P.A. of 1970, the corner points mentioned in lines 1 and 2 above were in conformance with regulations and rules therefore as required in the current manual of survey instructions of the United States Department of the Interior, Bureau of Land Management or by a decree of a Court of Law and/or that the corner points mentioned in lines 3, 4 and 5 above were in conformance with the rules of the Michigan Board of Land Surveyors or by a Decree of a Court of Law; established, re-established, monumented, re-monumented, recovered, found as expressed below.

NOTE: Not more than 4 corners, all in the same town and range, may be recorded on this certificate.

A. Description of original monument and accessories and/or subsequent restoration:

1st Quarter, 1839 Abner E. VanNess, Deputy Surveyor GLO "Set 1/4 Sec Post in lake"
R. Oak N 1.50 chains = 99.00'

April 12-14, 1902 Lyman W. June, County Surveyor "Old Stake"

September 4, 1984 Duane F. Wood RLS #24625 (Survey L11 P333 & 334) "Steel Bar"
6" Oak N35°E 28.3'
8" Oak S30°W 37.4'
18" Maple N85°W 48.2'

August 23, 1988 Gerald J. Gray RLS #17741 (LCRC L2 P229)
Found 3/4" iron
6" Oak N35°E 28.3'
8" Oak S30°W 37.4'
18" Maple N85°W 48.2'

APPROVED BY MECOSTA CO. PEER GROUP
IN ACCORDANCE WITH P.A. 343 of 1990

James J. Knapp
CHAIRMAN
DATE Oct. 24, 1996


B. Description of corner evidence found and/or method applied in restoring or reestablishing corner:

June 27, 1996 James J. Keller RLS #10693 "Found 3/4" Bolt with square head in C/L of pavement"
Looked for 1984 Wood witnesses', none found due to road right-of-way clearing. This location is in 7' of fill.
Set 60d SE side 6" Oak N24°E 25.75'
Set 60d South side 6" Ash N55°E 75.90'
Set 60d North side 6" Ash S59°W 36.96'
Found 60d East side 42" Oak N13°W 92.96'

C. Description of monument for corner and accessories established to perpetuate locating the position of the corner:

Accepted 3/4" bolt with square head and set remonumentation monument and box as a careful and faithful perpetuation of the position of the original corner.

Found 60d and set tag SE. side 6" Oak N54°E 36.90'
Found 60d and set tag S. side 6" Ash N24°E 75.79'
Found 60d and set tag N. side 6" Ash S60°W 25.71'
Found 60d and set tag E. side 42" Oak N13°W 92.92'
Fence to the East is 3' South of monument box

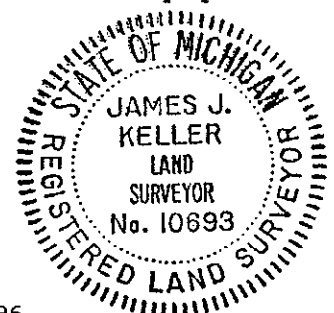

Signed by *James J. Keller* Date November 19, 1996
Surveyor's Michigan License No. 10693

Nov-19-1996 L JH

Found

as set

MAN BOX

