

**SURVEY & REMONUMENTATION**

MAR 14 2000

**SECTION**

**LAND CORNER RECORDATION CERTIFICATE**  
Filing Requirement of Act 74, Mich. P.A. 1970

STATE OF MICHIGAN  
COUNTY OF MECOSTA  
RECEIVED FOR RECORD

'99 DEC 14 P2:23

For corners in

<u>MECOSTA</u> (County)	Located In:	Corner Code #
1. Public Land Survey	T <u>15</u> N R <u>09</u> W	<u>H-6</u>
	T _____ R _____	_____
	T _____ R _____	_____
	T _____ R _____	_____
2. Property Controlling in Section	S _____ T _____ R _____	_____
	S _____	_____
	T _____ R _____	_____
3. Miscellaneous	S _____	_____
	T _____ R _____	_____
Property in Sec.	S _____	_____
	T _____ R _____	_____

*James Brown*  
REGISTER OF DEEDS

Register of Deeds Stamp & File Number

4. Lot No. \_\_\_\_\_, Recorded Plat \_\_\_\_\_

5. Private Claims \_\_\_\_\_

I, James H. Carter, in a field survey in November, 1999 do hereby state that under requirements of P.A. 74, Michigan P.A. of 1970, the corner points mentioned in lines 1 and 2 above were in conformance with regulations and rules therefore as required in the current manual of survey instructions of the United States Department of the Interior, Bureau of Land Management or by a decree of a Court of Law and /or that the corner points mentioned in lines 3, 4 and 5 above were in conformance with the rules of the Michigan Board of Land Surveyors or by a Decree of a Court of Law; established, re-established, monumented, recovered, found as expressed below:

**NOTE:** Not more than 1 corner, all in the same town and range, may be recorded on this certificate.

A. Description of original monument and accessories and/or subsequent restoration:  
Not Part of G. L. O.

B. Description of corner evidence found and/or method applied in restoring or reestablishing corner:

Fd Plow point with large stone beside it very near math center of Section 15, in old E-W fence line. Corner appears to be on the N - S Quarter line and about 1.2 ft North of the E-W Quarter line. Accepted position of the plow point as it indicates Proper subdivision of section 15.

C. description of monument for corner and accessories established to perpetuate locating the position of the corner:

CENTER SECTION 15, T 15 N, R 09 W.  
SET A STANDARD MECOSTA COUNTY REMONUMENTATION MONUMENT AT PLOW POINT LOCATION


- N 56 E - 42.68' - NAIL & TAG IN 18" OAK
- N 63 E - 5.74' - NAIL & TAG IN 4" MAPLE
- N 86 E - 32.92' - NAIL & TAG IN 28" ASH QUAD
- S 63 E - 22.50' - NAIL & TAG IN 29" BEECH
- S 20 W - 22.76' - NAIL & TAG IN 21" MAPLE

1	A	B	C	D	E	F	G	H	I	J	K	L	M
2		6		5		4		3		2		1	
3													
4		7		8		9		10		11		12	
5													
6		18		17		16		15		14		13	
7													
8		19		20		21		22		23		24	
9													
10		30		29		28		27		26		25	
11													
12		31		32		33		34		35		36	
13													

Signed by James H. Carter

Date DEC 15, 1999

Surveyor's Michigan License No. 33973

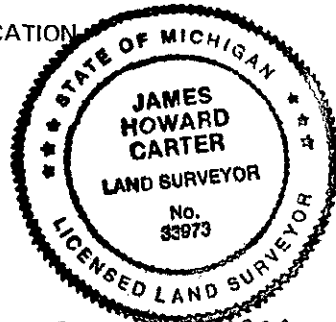

APPROVED BY MECOSTA CO. PEER GROUP  
IN ACCORDANCE WITH P.A. 345 of 1990

FORM APPROVED BY MICHIGAN STATE BOARD OF PROFESSIONAL SURVEYOR

JAN. 28, 1971

REVISED MAY 14, 1995

James H. Knapp  
CHAIRMAN  
DATE DEC. 3, 1999

LIBER 101 PAGE 273

REVISED JAN., 1971  
REVISED OCT., 1971