

SURVEY &
REMONUMENTATION

MAR 14 2000

SECTION

LAND CORNER RECORDATION CERTIFICATE
Filing Requirement of Act 74, Mich. P.A. 1970

STATE OF MICHIGAN
COUNTY OF MECOSTA
RECEIVED FOR RECORD

'99 DEC 14 P2:23

For corners in

<u>MECOSTA</u> (County)	Located In:	Corner Code #
1. Public Land Survey	T <u>15 N</u> R <u>09 W</u>	<u>J-6</u>
	T _____ R _____	_____
	T _____ R _____	_____
	T _____ R _____	_____
2. Property Controlling in Section	S _____ T _____ R _____	_____
	S _____	_____
	T _____ R _____	_____
3. Miscellaneous	S _____	_____
	T _____ R _____	_____
Property in Sec.	S _____	_____
	T _____ R _____	_____

Joan Brown
REGISTER OF DEEDS

Register of Deeds Stamp & File Number

4. Lot No. _____, Recorded Plat _____

5. Private Claims _____

I, James H. Carter, in a field survey in November, 1999 do hereby state that under requirements of P.A. 74, Michigan P.A. of 1970, the corner points mentioned in lines 1 and 2 above were in conformance with regulations and rules therefore as required in the current manual of survey instructions of the United States Department of the Interior, Bureau of Land Management or by a decree of a Court of Law and /or that the corner points mentioned in lines 3, 4 and 5 above were in conformance with the rules of the Michigan Board of Land Surveyors or by a Decree of a Court of Law; established, re-established, monumented, recovered, found as expressed below:

NOTE: Not more than 1 corner, all in the same town and range, may be recorded on this certificate.

A. Description of original monument and accessories and/or subsequent restoration:
Not Part of G. L. O.

B. Description of corner evidence found and/or method applied in restoring or reestablishing corner:

All govt corners around Section 14 have been approved under the Remonumentation program and the mathematical Intersection of Section 14 falls in a lake. Accepted math intersection, also set two reference monuments for the center of said Section.


C. description of monument for corner and accessories established to perpetuate locating the position of the corner:

CENTER SECTION 14, T 15 N, R 09 W.
SET A STANDARD MECOSTA COUNTY REMONUMENTATION MONUMENT ON PIPE IN LAKE.

REF MON SET ON E-W 1/4 LINE SEC 14, 600.00' WEST OF CENTER (J-6).
S 39 E - 37.05' - NAIL & TAG IN 18" R. OAK S 31 W - 43.78' - NAIL & TAG IN 11" R. OAK
S 15 E - 11.72' - NAIL & TAG IN 6" R. PINE S 56 W - 14.85' - NAIL & TAG IN 4" R. PINE

REF MON SET ON N-S 1/4 LINE SEC 14, 895.98' SOUTH OF CENTER (J-6).
NORTH - 42.97' - NAIL & TAG IN 9" PINE S 78 E - 16.35' - NAIL & TAG IN 28" MAPLE
S 30 W - 14.48' - NAIL & TAG IN 12" ASH S 77 W - 46.67' - NAIL & TAG IN 11" PINE

	A	B	C	D	E	F	G	H	I	J	K	L	M
1													
2		6		5		4		3		2		1	
3													
4		7		8		9		10		11		12	
5													
6		18		17		16		15		14		13	
7													
8		19		20		21		22		23		24	
9													
10		30		29		28		27		26		25	
11													
12		31		32		33		34		35		36	
13													

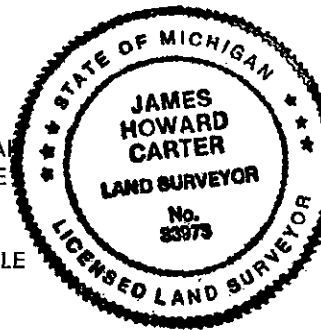

Signed by James H. Carter Date DEC 13, 1999

Surveyor's Michigan License No. 33973

APPROVED BY MECOSTA CO. PEER GROUP
IN ACCORDANCE WITH P.A. 345 of 1990

James H. Knapp
CHAIRMAN
DEC 3, 1999

FORM APPROVED BY MICHIGAN STATE BOARD OF PROFESSIONAL SURVEYOR