

# MECOSTA COUNTY REMONUMENTATION PROGRAM

CORNER APPROVED BY PEER GROUP ON 6-12-98  
 LAND CORNER RECORDATION CERTIFICATE

Filing Requirement of Act 74, Mich. P.A. 1970

For Corners in

Mecosta  
(County)

Located In: Corner Code #

T	15N	R	9W	J-09
T	_____	R	_____	_____
T	_____	R	_____	_____
T	_____	R	_____	_____
S	T	R	_____	_____
S	T	R	_____	_____
S	T	R	_____	_____
S	T	R	_____	_____

STATE OF MICHIGAN  
 COUNTY OF MECOSTA  
 RECEIVED FOR RECORD

'98 AUG 19 A9:54

1. Public Land Survey

SURVEY &  
 REMONUMENTATION

*James Brown*  
 REGISTER OF DEEDS

OCT 29 1998

2. Property controlling in Section  
 3. Miscellaneous Property in Sec.

SECTION

Register of Deeds Stamp & File Number

4. Lot No. \_\_\_\_\_, Recorded Plat \_\_\_\_\_  
 5. Private Claims \_\_\_\_\_

	A	B	C	D	E	F	G	H	I	J	K	L	M
1													
2	6	7	8	9	10	11	12						
3													
4	13	14	15	16	17	18	19	20	21	22	23	24	
5													
6	25	26	27	28	29	30	31	32	33	34	35	36	
7													
8	37	38	39	40	41	42	43	44	45	46	47	48	
9													
10	49	50	51	52	53	54	55	56	57	58	59	60	
11													
12	61	62	63	64	65	66	67	68	69	70	71	72	
13													

I, James H. Carter, in a field survey on May 30, 1998, do hereby certify that under requirements of P.A. 74, Michigan P.A. of 1970, the corner points mentioned in lines 1 and 2 above were in conformance with regulations and rules therefore as required in the current manual of survey instructions of the United States Department of the Interior, Bureau of Land Management or by a decree of court law and/or that the corner points mentioned in lines 3, 4 and 5 above were in conformance with the rules of Michigan Board of Land Surveyors or by a decree of a court of law; established, re-established, monumented, re-monumented, recovered, found as expressed below:

**NOTE: Only one corner may be recorded on this certificate.**

A. Description of original monument and accessories and /or subsequent restoration:

- 1837 - JAN, DEPUTY SURVEYOR, A. E. VAN NESS, SET 1/4 POST, PINE 36" - S 67 E - 16 LINKS, BEECH 12" - N 38 E - 27 LINKS.
- 1895 - L. W. JUNE - 36" PINE STUMP - S 67 E - 16 L (OBT), 24" PINE STUMP - S 70 W - 41 L.
- 1989 - LCRC L-11, P -355, JOHN E. McLANE SET RR SPIKE IN NWLY TRUNK BASE OF 12" MAPLE PER LYMAN JUNE RECORD DISTANCES. NAIL / RLS TAG IN N SIDE OF 30" WHITE ASH - AZ 99 - 23.48', NAIL / RLS TAG N SIDE OF CLUSTER MAPLE - AZ 282 71.57', NAIL / RLS TAG NE SIDE 6" MAPLE - AZ 303 - 48.72', NAIL / RLS TAG SW SIDE OF 10" W. OAK - AZ 330 - 28.60'.

APPROVED BY MECOSTA CO. PEER GROUP  
 IN ACCORDANCE WITH P.A. 345 of 1990  
*James G. Knapp*  
 CHAIRMAN  
 DATE JUNE 12, 1998


B. Description of corner evidence found and/or method applied in restoring or reestablishing corner:

FOUND OLD TILE WITH STEEL ROD UNDER ROOTS ON SLY SIDE OF SAID 14" MAPLE (LCRC L-11,P-355) AS STATED ABOVE. RR SPIKE IS ABOUT ONE AND A HALF FT (+/-) NORTH OF TILE IN BASE OF SAME TREE. MOST ACCESSORIES HAVE BEEN CUT IN TIMBER SALE, OR (IN-GROWN) INTO ITS TREE. JOHN McLANE WAS PRESENT AT THE SITE WHEN THE TILE WAS REVEALED.

SET MECOSTA COUNTY REMONUMENTATION MONUMENT IN TILE.

C. Description of monument for corner and accessories established to perpetuate locating the position of the corner:

J-9 - SOUTH 1/4 CORNER OF SECTION 23, T15N, R09W.  
 SET A STANDARD MECOSTA COUNTY REMONUMENTATION MONUMENT AND IS ACCEPTED AS FAITHFUL RE-ESTABLISHMENT OF THE POSITION OF THE ORIGINAL CORNER.  
 S 83 E - 22.98' - NAIL AND TAG IN 32" WHITE ASH  
 N 43 E - 8.31' - NAIL AND TAG IN 13" MAPLE  
 N 04 W - 1.66' - NAIL AND TAG IN 13" MAPLE  
 N 27 W - 31.39' - NAIL AND TAG IN 8" ASH

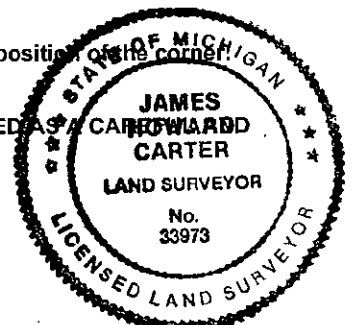

Signed by James H. Carter Date July 24, 1998  
 Surveyor's Michigan License No. 33973