

SURVEY & REMONUMENTATION

MECOSTA COUNTY REMONUMENTATION PROGRAM

MAR 03 1999

CORNER APPROVED BY PEER GROUP ON Nov 13, 1998
 LAND CORNER RECORDATION CERTIFICATE

Filing Requirement of Act 74, Mich. P.A. 1970

STATE OF MICHIGAN
 COUNTY OF MECOSTA
 RECEIVED FOR RECORD

SECTION
 For Corners in

Located In:	Corner Code #
Mecosta (County)	
T 15N R 9W K-06	
T _____ R _____	
T _____ R _____	
T _____ R _____	
S T _____ R _____	
S T _____ R _____	
S T _____ R _____	
S T _____ R _____	

'98 DEC 28 A8:36

Joanna Brown
 REGISTER OF DEEDS

1. Public Land Survey

2. Property controlling in Section

3. Miscellaneous Property in Sec.

4. Lot No. _____, Recorded Plat _____
 5. Private Claims _____

Register of Deeds Stamp & File Number

I, James H. Carter, in a field survey on Oct 26, 1998 do hereby certify that under requirements of P.A. 74, Michigan P.A. of 1970, the corner points mentioned in lines 1 and 2 above were in conformance with regulations and rules therefore as required in the current manual of survey instructions of the United States Department of the Interior, Bureau of Land Management or by a decree of court law and/or that the corner points mentioned in lines 3, 4 and 5 above were in conformance with the rules of Michigan Board of Land Surveyors or by a decree of a court of law; established, re-established, monumented, re-monumented, recovered, found as expressed below:

	A	B	C	D	E	F	G	H	I	J	K	L	M
1													
2	6	7	8	9	10	11	12						
3													
4	7	8	9	10	11	12							
5													
6	18	17	16	15	14	13							
7													
8	19	20	21	22	23	24							
9													
10	30	29	28	27	26	25							
11													
12	31	32	33	34	35	36							
13													

NOTE: Only one corner may be recorded on this certificate.

APPROVED BY MECOSTA CO. PEER GROUP
 IN ACCORDANCE WITH P.A. 345 of 1990
James H. Krapp
 CHAIRMAN
 DATE Nov. 13, 1998


A. Description of original monument and accessories and/or subsequent restoration:

- 1838 - JAN-FEB, DEPUTY SURVEYOR, A. E. VAN NESS, SET 1/4 POST. 12" TAMARACK - N 30 E - 15 LINKS
 6" TAMARACK - S 10 W - 18 LINKS
- 1895 - L. W. JUNE, FD OLD STAKE, REWITNESSED, 20" PINE STUMP - N 40 W - 37 1/2 L, 20" PINE STUMP - S 40 W - 24 L.
- 1909 - GEO. H. WILLITS - DEPENDENT RESURVEY, CALLS FOR A TILE CORNER.
- 1969 - W. H. WRIGHT - SURVEY SHOWS A DISTANCE BETWEEN THE NW COR SEC 13 AND THE W 1/4 SECTION 13 TO BE 1329' AND 1329'. NO WITNESSES SHOWN.
- 1976 - MID - MICHIGAN, LIBER 10, PAGE 352 AND LIBER 10 PAGE 377. SET 1/2" RE-BAR - 10" POPLAR - S 45 W - 23.17', 10" W. BIRCH - N60 W - 27.39', 12" POPLAR - S 20 E - 64.38'.
- 1978 - MID - MICHIGAN, LIBER 10, PAGE 523, FOUND 1/2" IRON ROD - S 45 W - 23.17' - 10" POPLAR, N 60 W - 27.39' - 10" BIRCH, S 20 E - 64.38' - 12" POPLAR.

B. Description of corner evidence found and/or method applied in restoring or reestablishing corner:
 FOUND 1/2" RE-ROD, DID NOT ACCEPT POSITION BECAUSE OF TWO RECENT DISCOVERED TILES, BOTH A HALF MILE (GOV MEA.) NORTH AND SOUTH OF 1/4 CORNER LOCATION. DUG WITH BACKHOE AND SHOVEL, DID NOT FIND TILE AT 1/4 CORNER LOCATION. SET MECOSTA COUNTY REMON MONUMENT AT PROPER PROPORTION, USING WILLITS DEPENDENT RESURVEY OF SECTION 13. SHARED THIS INFORMATION WITH JERALD GREY OF MID MICHIGAN ENGINEERING & SURVEYING CO.

C. Description of monument for corner and accessories established to perpetuate locating the position of the corner:

K-6 - CORNER COMMON TO SECTIONS 13 AND 14, T15N, R09W.
 SET A STANDARD MECOSTA COUNTY REMONUMENTATION MONUMENT AND IS ACCEPTED AS A CAREFUL AND FAITHFUL RE-ESTABLISHMENT OF THE POSITION OF THE ORIGINAL CORNER.
 N 75 E - 57.94' - NAIL AND TAG IN 24" CHERRY.
 S 38 W - 62.23' - N END OF 12" CMP.
 N 55 W - 42.10' - NAIL AND TAG IN 10" CEDAR.
 N 30 W - 46.02' - NAIL AND TAG IN 12" CEDAR.

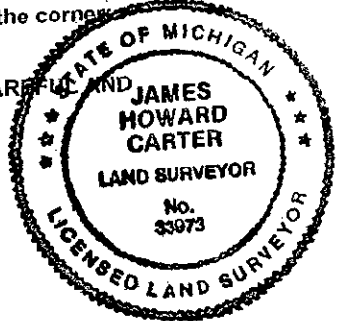

Signed by James H. Carter Date Nov 25, 1998
 Surveyor's Michigan License No. 33973

FORM APPROVED BY MICHIGAN STATE BOARD OF LAND SURVEYORS, JAN 28, 1971
 REVISED MAY 14, 1975
 REVISED JAN, 1983