

SURVEY & REMONUMENTATION

MECOSTA COUNTY REMONUMENTATION PROGRAM

MAR 03 1999

CORNER APPROVED BY PEER GROUP ON Nov 13, 1998
 LAND CORNER RECORDATION CERTIFICATE

Filing Requirement of Act 74, Mich. P.A. 1970

For Corners in **SECTION**

STATE OF MICHIGAN
 COUNTY OF MECOSTA
 RECEIVED FOR RECORD

'98 DEC 28 A8:36

James Brown
 REGISTER OF DEEDS

Register of Deeds Stamp & File Number

Mecosta (County)	Located In:		Corner Code #
	T 15N	R 9W	
	T	R	K-08
	T	R	
1. Public Land Survey	T	R	
	T	R	
	S	R	
	S	R	
	S	R	
	S	R	

- 2. Property controlling in Section
- 3. Miscellaneous Property in Sec.

4. Lot No. _____, Recorded Plat _____

5. Private Claims _____

I, James H. Carter, in a field survey on Oct 26, 1998 do hereby certify that under requirements of P.A. 74, Michigan P.A. of 1970, the corner points mentioned in lines 1 and 2 above were in conformance with regulations and rules therefore as required in the current manual of survey instructions of the United States Department of the Interior, Bureau of Land Management or by a decree of court law and/or that the corner points mentioned in lines 3, 4 and 5 above were in conformance with the rules of Michigan Board of Land Surveyors or by a decree of a court of law; established, re-established, monumented, re-monumented, recovered, found as expressed below:

	A	B	C	D	E	F	G	H	I	J	K	L	M
1													
2		6		5		4		3		2		1	
3													
4		7		8		9		10		11		12	
5													
13													

NOTE: Only one corner may be recorded on this certificate.

A. Description of original monument and accessories and for subsequent restoration:

1838 - JAN-FEB, DEPUTY SURVEYOR, A. E. VAN NESS, SET 1/4 POST. 20" HEMLOCK - N 84 W - 10 LINKS
 6" TAMARACK - S 36 E - 8 LINKS

1895 - L. W. JUNE, 36" PINE STUMP - S ?? E - 47 L,

DATE UNKNOWN - OLD PERE MARQUETTE, NOW CSX RAILROAD PLANS, CALL FOR A TILE 412.5' SOUTHERLY OF CENTERLINE OF RAILROAD.

1996 - MID - MICHIGAN SURVEY, FD 12" IRON, 6" WILLOW - N 18 E - 75.99', 30" MAP - S 78 E - 30.15',
 4" POP - S 70 W - 63.23', 3" CHERRY - S 85 W - 25.58'.


B. Description of corner evidence found and/or method applied in restoring or reestablishing corner:
 FOUND 12" RE-ROD, DUG 2 FT AND FOUND TILE. ACCEPTED POSITION AND SET MECOSTA COUNTY REMONUMENT IN CENTER OF TILE.

C. Description of monument for corner and accessories established to perpetuate locating the position of the corner:

K-8 - CORNER COMMON TO SECTIONS 23 AND 24, T15N, R09W.
 SET A STANDARD MECOSTA COUNTY REMONUMENTATION MONUMENT AND IS ACCEPTED AS A CAREFUL AND FAITHFUL RE-ESTABLISHMENT OF THE POSITION OF THE ORIGINAL CORNER.
 FD, S 75 E - 30.16' - 41" MAPLE. (O.B.T.)
 SET, S 75 E - 28.85' - NAIL & TAG IN N SIDE OF 41" MAPLE.
 S 02 E - 193.64' - NAIL AND TAG IN FENCE POST.
 S 84 W - 45.72' - NAIL AND TAG IN 8" POP.
 N 03 W - 214.80' - NAIL & TAG IN 25" MAPLE

APPROVED BY MECOSTA CO. PEER GROUP
 IN ACCORDANCE WITH P.A. 345 of 1990

James H. Knapp
 CHAIRMAN
 DATE Nov. 13, 1998

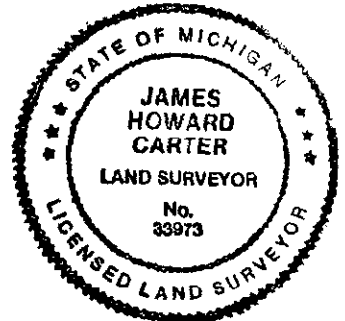

Signed by James H. Carter

Date Nov 25, 1998

Surveyor's Michigan License No. _____

33973