

**SURVEY &
REMONUMENTATION**

MECOSTA COUNTY REMONUMENTATION PROGRAM

APR 04 1996

CORNER APPROVED BY PEER GROUP ON MAY 18, 1995

COMMISSION

LAND CORNER RECORDATION CERTIFICATE

Filing Requirement of Act 74, Mich. P.A. 1970

Joanne Brown
Register of Deeds
Mecosta County

'95 NOV -2 A11 :13

For corners in _____ Located In: _____ Corner Code # _____

Mecosta
(County)

1. Public Land Survey Sec 15 T 15N R 7W _____ G-6 _____
 T _____ R _____
 T _____ R _____
 T _____ R _____

2. Property Controlling S _____ T _____ R _____
 in Section S _____ T _____ R _____

3. Miscellaneous S _____ T _____ R _____
 Property in Sec. S _____ T _____ R _____

Register of Deeds Stamp & File Number

4. Lot No. _____, Recorded Plat _____

5. Private Claims _____

I, James J. Keller, in a field survey on February 19 95, do hereby certify that under requirements of P.A. 74, Michigan P.A. of 1970, the corner points mentioned in lines 1 and 2 above were in conformance with regulations and rules therefore as required in the current manual of survey instructions of the United States Department of the Interior, Bureau of Land Management or by a decree of a Court of Law and/or that the corner points mentioned in lines 3, 4 and 5 above were in conformance with the rules of the Michigan Board of Land Surveyors or by a Decree of a Court of Law; established, re-established, monumented, re-monumented, recovered, found as expressed below:

NOTE: Not more than 4 corners, all in the same town and range, may be recorded on this certificate.

A. Description of original monument and accessories and/or subsequent restoration:
 1839 Noah Brookfield, Deputy Surveyor, GLO Notes, Set 1/4 post 15-16
 Hemlock 20" S77°E 22 Links, Beech 6" N21°W 2 Links
 1895-1896 Lyman W. June, County Surveyor,
 Beech 8" N7°E 56 Links, Beech 10" S45°E 81 Links
 May 22-23 1905 Lyman W. June, County Surveyor, Tile Corner
 April 22 1915 Walter Willets County Surveyor, Found Tile corner,
 Telephone pole S31°E, Hemlock Stump S71°W
 1940 M-66 Road Plans Project # 54-23 (No Corner shown)
 September 1 1977 Gray # 17741 Found 1" pipe (L1-P322)
 Iron N60°E 68.48'

APPROVED BY MECOSTA CO. PEER GROUP
IN ACCORDANCE WITH P.A. 345 of 1990


James G. Knapp
CHAIRMAN
DATE MAY 18, 1995

	A	B	C	D	E	F	G	H	I	J	K	L	M
1													
2	6	5	4	3	2	1							
3													
4	7	8	9	10	11	12							
5													
6	18	17	16	15	14	13							
7													
8	19	20	21	22	23	24							
9													
10	30	29	28	27	26	25							
11													
12	31	32	33	34	35	36							
13													

B. Description of corner evidence found and/or method applied in restoring or reestablishing corner:
 January 19, 1995 James J. Keller #10693 Found 1 1/2" well point 0.80' long 3' West of centerline of M-66 in intersection of M-66 and Taft Rd. At 1.0' below surface found fragments of clay tile. At 2.4' below surface found a 3" clay tile 1.0' long with remains of a wood stake inside and a 1/2" Iron Bar 18" long on the East side of the tile.
 Found nail in Telephone Pole N53°E 78.87'
 Set Pk nail South side Telephone Pole S35°E 100.30'
 S.W. Corner Building N37°E 138.40'
 Found nail in Service Pole S55°W 69.25'

C. Description of monument for corner and accessories established to perpetuate locating the position of the corner; Set Remonumentation Monument in Monument box and accepted as a careful and faithful perpetuation of the position of the original corner.

Found nail and set tag in Telephone Pole N53°E 78.87'
 Set Pk nail and set tag South side Telephone Pole S35°E 100.30'
 S.W. Corner Building N37°E 138.40'
 Found nail and set tag in Service Pole S55°W 69.25'

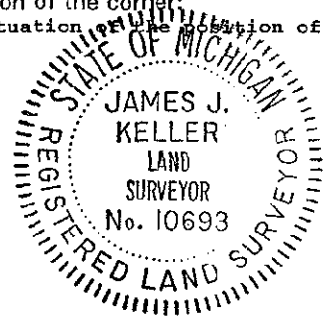

Signed by James J. Keller Date 27 June 1995
 Surveyor's Michigan License No. 10693