

**SURVEY &
REMONUMENTATION**

APR 04 1996

MECOSTA COUNTY REMONUMENTATION PROGRAM

CORNER APPROVED BY PEER GROUP ON MAY 18, 1995

COMMISSION

LAND CORNER RECORDATION CERTIFICATE

Filing Requirement of Act 74, Mich. P.A. 1970

Joanne Brown
Register of Deeds
Mecosta County

'95 NOV -2 A11:13

For corners in
Mecosta
(County)

Located In: _____ Corner Code # _____

1. Public Land Survey Sec 15 T 15 R 7 _____ G-7
 T _____ R _____
 T _____ R _____
 T _____ R _____

2. Property Controlling S _____ T _____ R _____
 in Section S _____ T _____ R _____

3. Miscellaneous S _____ T _____ R _____
 Property in Sec. S _____ T _____ R _____

4. Lot No. _____, Recorded Plat _____

5. Private Claims _____

Register of Deeds Stamp & File Number

I, James J. Keller, in a field survey on February 19 95, do hereby certify that under requirements of P.A. 74, Michigan P.A. of 1970, the corner points mentioned in lines 1 and 2 above were in conformance with regulations and rules therefore as required in the current manual of survey instructions of the United States Department of the Interior, Bureau of Land Management or by a decree of a Court of Law and/or that the corner points mentioned in lines 3, 4 and 5 above were in conformance with the rules of the Michigan Board of Land Surveyors or by a Decree of a Court of Law; established, re-established, monumented, re-monumented, recovered, found as expressed below:

	A	B	C	D	E	F	G	H	I	J	K	L	M
1													
2	6	5	4	3	2	1							
3													
4	7	8	9	10	11	12							
5													
6	18	17	16	15	14	13							
7													
8	19	20	21	22	23	24							
9													
10	30	29	28	27	26	25							
11													
12	31	32	33	34	35	36							
13													

NOTE: Not more than 4 corners, all in the same town and range, may be recorded on this certificate.


A. Description of original monument and accessories and/or subsequent restoration:
 July 20 1838 Noah Brookfield Deputy Surveyor, GLO notes, Set post common Sections 15-16-21-22, Hemlock 18" S39°W 50 Links, Beech 14" N48°E 67 Links.
 1895-96 Lyman W. June, County Surveyor, "Hemlock Stub 18" S55°E 56 Links, One Old Bearing Tree down marks plane, Center of Town" (corner located by still existing town hall)
 1940 M-66 Road Plans, Project 54-23 Station 311+77.9, Angle Iron N25°W 60.15', 14" Maple S30°W 50.68', 10" Maple N80°E 53.91
 January 10 1976 Herbert L. Fluharty #18223 (LCRC L1 Pg188) Found monument box in Centerline M-66 & 15 Mile Rd. Set 5/8" x 18" Rebar & Cap, Telephone Pole N56°E 63.34', SE. Corner House N40°W 109.24', 34" Oak S31°W 67.97'
 February 27, 1979 Thomas J. Mueller #25861 LCRC (L1 - P188) as well as Recorded Survey (L10 Pg778) Found 5/8" Iron & cap in Mon Box, Telephone Pole N56°E 63.34', SE. Corner House N40°W 109.24', 34" Oak S31°W 67.97'

B. Description of corner evidence found and/or method applied in restoring or reestablishing corner:
 January 19, 1995 James J. Keller #10693 Found Rebar & cap #18223 in Monument Box Intersection M-66 and 15 Mile Road. Excavated to a depth of 2.6' where a stone set on end below the rebar was found.
 Concrete R/W Post N57°W 62.80'
 Set Pk in Telephone Pole N69°E 80.50'
 Concrete R/W Post S57°E 68.15'
 Found 40d Nail in North West Side 40" Maple S26°W 68.45'
 Set Pk Nail in Telephone Pole S47°W 75.23'

APPROVED BY MECOSTA CO. PEER GROUP
IN ACCORDANCE WITH P.A. 345 of 1990

James J. Knapp
CHAIRMAN
DATE MAY 18, 1995

C. Description of monument for corner and accessories established to perpetuate locating the position of the corner:
 Set Remonumentation Monument 0.40' below surface in Monument box and accepted as a careful and faithful perpetuation of the position of the original corner.
 Concrete R/W Post N57°W 62.80'
 Set Pk nail and tag in Telephone Pole N69°E 80.50'
 Concrete R/W Post S57°E 68.15'
 Found 40d Nail and set tag in North West Side 40" Maple S26°W 68.45'
 Set Pk Nail and tag in Telephone Pole S47°W 75.23'

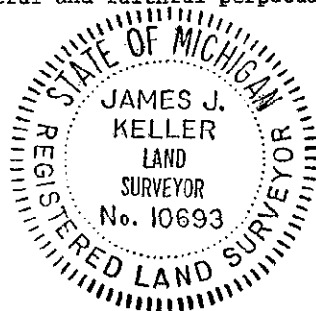

Signed by *James J. Keller* Date 27 June 1995
 Surveyor's Michigan License No. 10693