

REMOVED

MECOSTA COUNTY REMONUMENTATION PROGRAM

MAY 15 1997

CORNER APPROVED BY PEER GROUP ON April 15, 1996

LAND CORNER RECORDATION CERTIFICATE

COMMISSION

Filing Requirement of Act 74, Mich. P.A. 1970

For corners in Mecosta Located in: Sheridan Township Corner Code # _____
 (County)

1. Public Land Survey	SEC 27	T 15N	R 07W	G-10
		T _____	R _____	_____
		T _____	R _____	_____
		T _____	R _____	_____
2. Property Controlling in Section	S _____	T _____	R _____	_____
	S _____	T _____	R _____	_____
3. Miscellaneous Property in Sec.	S _____	T _____	R _____	_____
	S _____	T _____	R _____	_____

4. Lot No. _____, Recorded Plat _____
 5. Private Claims _____

STATE OF MICHIGAN
 COUNTY OF MECOSTA
 RECEIVED FOR RECORD

96 OCT 29 AM 11:12

REGISTER OF DEEDS

Register of Deeds Stamp & File Number

I, James J. Keller, in a field survey on December 16, 1991, do hereby certify that under requirements of P.A. 74, Michigan P.A. of 1970, the corner points mentioned in lines 1 and 2 above were in conformance with regulations and rules therefore as required in the current manual of survey instructions of the United States Department of the Interior, Bureau of Land Management or by a decree of a Court of Law and/or that the corner points mentioned in lines 3, 4 and 5 above were in conformance with the rules of the Michigan Board of Land Surveyors or by a Decree of a Court of Law, established, re-established, monumented, re-monumented, recovered, found as expressed below:

NOTE: Not more than 4 corners, all in the same town and range, may be recorded on this certificate.

A. Description of original monument and accessories and/or subsequent restoration:

- June 7, 1839 Noah Brookfield, Deputy Surveyor GLO, "Set 1/4 Sec. Post"
 20" Hemlock N63°W - 5 links = 3.30'
 10" Maple S25°E - 20 links = 13.20'
- 1895-1896 Lyman W. June, County Surveyor (Record Book 1 Page 288)
 Log School House S35°W 130 links - Original = 85.80'
- 1940 MSHD Impr. Proj. Job No. 03551 P.O.T. M-66 PI Arthur Rd. Sta. 232+77.35
 P. Pole S55°E 65.88'
 Guy Pole N50°E 84.35'
 Face of Pipe N70°E 92.39'
 Gas Line Marker
- July 5, 1972 Patrick Salisbury RLS #13594 (Survey L10 P58) "Found iron"
 Nail P. Pole N35°E 84.35'
 Nail P. Pole S50°E 66.00'
 Nail P. Pole N45°E 99.07'
- February 27, 1979 Thomas J. Mueller RLS #25861 (LCRC L1 P474) "Found 1/2" Iron in Mon Box"
 Nail in P. Pole S58°E 65.95'
 Nail in P. Pole N48°E 84.38'
 Nail in P. Pole N35°W 99.54'
 Nail in P. Pole S43°W 74.43'
- December 16, 1991 James J. Keller RLS #10693 "Found 1/2" Iron in Mon Box"
 End Nail in Distribution Pole N35°W 99.60'
 End Nail in Guy Pole N47°E 84.42'
 End 40d in Distribution Pole S60°E 66.00'
 End Form Nail & roofing cap in guy pole S48°W 74.40'

B. Description of corner evidence found and/or method applied in restoring or reestablishing corner:

- Mar 29, 1996 James J. Keller RLS #10693 "Found 3/8" Copper Clad Steel Tubing"
 End Nail in Distribution Pole N35°W 99.60'
 End Nail in Guy Pole N47°E 84.42'
 End 40d in Distribution Pole S60°E 66.00'
 End Form Nail & roofing cap in guy pole S48°W 74.40'

C. Description of monument for corner and accessories established to perpetuate locating the position of the corner:

- Accept 3/8" Copper Clad Steel Tubing and Set Remonumentation Monument and accepted as a careful and faithful perpetuation of the position of the original corner.
 Set PK nail and tag SW side Distribution pole N35°W 99.58'
 Set PK nail and tag SE side Guy pole N47°E 84.41'
 Set 60d and tag SW side Distribution pole S60°E 66.00'
 Set 60d nail and tag SE side Guy pole S48°W 74.38'
 Found MSHD tag in Guy pole N47°E 84.38'

Signed by James J. Keller Date April 19, 1996

Surveyor's Michigan License No. 10693

	A	B	C	D	E	F	G	H	I	J	K	L	M
1													
2	6	5	4	3	2	1							
3													
4	7	8	9	10	11	12							
5													
6	18	17	16	15	14	13							
7													
8	19	20	21	22	23	24							
9													
10	30	29	28	27	26	25							
11													
12	31	32	33	34	35	36							
13													


APPROVED BY MECOSTA CO. PEER GROUP
 IN ACCORDANCE WITH P.A. 345 of 1990

James J. Knapp
 CHAIRMAN
 DATE APRIL 15, 1996




Aug - 14 - 1976

JJK, LJH, TOB

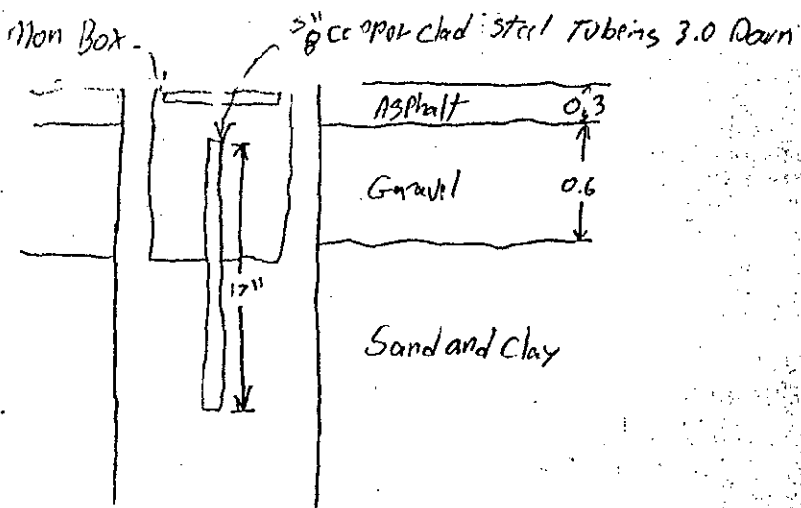

as Found

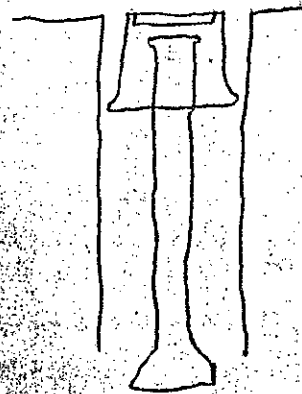

as Set