

**SURVEY &
REMONUMENTATION**

MECOSTA COUNTY REMONUMENTATION PROGRAM

APR 04 1996 CORNER APPROVED BY PEER GROUP ON MAY 18, 1995

COMMISSION

LAND CORNER RECORDATION CERTIFICATE

Filing Requirement of Act 74, Mich. P.A. 1970

For corners in Mecosta Located In: _____ Corner Code # _____
(County)

1. Public Land Survey SEC 15 T 15N R 7W _____ I-6 _____
T _____ R _____
T _____ R _____
T _____ R _____

2. Property Controlling S _____ T _____ R _____
in Section S _____ T _____ R _____

3. Miscellaneous S _____ T _____ R _____
Property in Sec. S _____ T _____ R _____

4. Lot No. _____, Recorded Plat _____

5. Private Claims _____

Joanne Brown
Register of Deeds
Mecosta County
'95 NOV -2 A11:13

Register of Deeds Stamp & File Number

I, James J. Keller, in a field survey on February 1 19 95, do hereby certify that under requirements of P.A. 74, Michigan P.A. of 1970, the corner points mentioned in lines 1 and 2 above were in conformance with regulations and rules therefore as required in the current manual of survey instructions of the United States Department of the Interior, Bureau of Land Management or by a decree of a Court of Law and/or that the corner points mentioned in lines 3, 4 and 5 above were in conformance with the rules of the Michigan Board of Land Surveyors or by a Decree of a Court of Law; established, re-established, monumented, re-monumented, recovered, found as expressed below:


NOTE: Not more than 4 corners, all in the same town and range, may be recorded on this certificate.

- A. Description of original monument and accessories and/or subsequent restoration:
1839 Noah Brookfield, GLO, Triple Black Ash 10" for 1/4 Section Post, (Book 1 Page 92)
1895 Lyman W. June, On West side B. Ash 12"
May 16, 17, & 18, 1898, Lyman W. June County Surveyor "Tile Corner at East end of Stone" (Book 1 Page 46).
May 22&23 1905, Lyman W. June, County Surveyor, "Tile Corner".
Sept. 1, 1977; Gray #17741 Set 1/2", rebar S40°E 36.55' Telephone Pole, N40°E 40.4' Telephone Pole, N80°W 87.3' 12" Box Elder
April 15 1984, Duane F. Wood #24625 Recorded (L11 - P305) & (L11 - P378) Found Corner 18" deep, R.R. Spike in Road intersection N & E-W, East 76.10', 14" Maple N40°W 29.30', 16" Oak S60°W 69.90

APPROVED BY MECOSTA CO. PEER GROUP
IN ACCORDANCE WITH P.A. 345 of 1990
James J. Knapp
CHAIRMAN
DATE MAY 18, 1995

- B. Description of corner evidence found and/or method applied in restoring or reestablishing corner:
Jan 27 1995 James J. Keller Found Cap #17741 / #24625 and Accepted. In Row Fence Posts South & Centerline blacktop E-W (Taft Road). Excavated cap and Iron; 18" beneath Iron encountered old road bed and 2" rail road rail 20" long, Beneath the rail entered water table and no other evidence was encountered.
Set 60d East side 18" Maple N48°W 41.88'
Found 40d Telephone Pole S68°E 102.68'
Set 60d West side 20" Black Ash S40°W 31.93'
Set 60d West side 18' Black Ash S75°W 50.45'

- C. Description of monument for corner and accessories established to perpetuate locating the position of the corner:
Accepted cap and set Remonumentation Monument
Set 60d and tag East side 18" Maple N48°W 41.88'
Found 40d Telephone Pole S68°E 102.68'
Set 60d and tag West side 20" Black Ash S40°W 31.93'
Set 60d and tag West side 18' Black Ash S75°W 50.45'

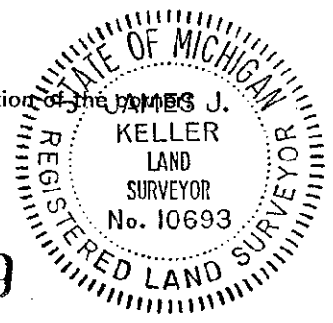

LIBER 100 49

Signed by James J. Keller Date June 27 1995
Surveyor's Michigan License No. 10693