

**SURVEY & REMONUMENTATION
MECOSTA COUNTY REMONUMENTATION PROGRAM**

APR 04 1996 **CORNER APPROVED BY PEER GROUP ON MAY 18, 1995**

COMMISSION **LAND CORNER RECORDATION CERTIFICATE**
Filing Requirement of Act 74, Mich. P.A. 1970

Joanne Brown
Register of Deeds
Mecosta County

'95 NOV -2 A11:13

For corners in Mecosta (County) Located in: _____ Corner Code # _____

1. Public Land Survey SEC 22 T 15 R 07 _____ I-8 _____
 T _____ R _____
 T _____ R _____
 T _____ R _____

2. Property Controlling S _____ T _____ R _____
 in Section S _____ T _____ R _____

3. Miscellaneous S _____ T _____ R _____
 Property in Sec. S _____ T _____ R _____

4. Lot No. _____, Recorded Plat _____

5. Private Claims _____

Register of Deeds Stamp & File Number

I, James J. Keller, in a field survey on February 1 1995, do hereby certify that under requirements of P.A. 74, Michigan P.A. of 1970, the corner points mentioned in lines 1 and 2 above were in conformance with regulations and rules therefore as required in the current manual of survey instructions of the United States Department of the Interior, Bureau of Land Management or by a decree of a Court of Law and/or that the corner points mentioned in lines 3, 4 and 5 above were in conformance with the rules of the Michigan Board of Land Surveyors or by a Decree of a Court of Law; established, re-established, monumented, re-monumented, recovered, found as expressed below:

	A	B	C	D	E	F	G	H	I	J	K	L	M
1													
2	6	5	4	3	2	1							
3													
4	7	8	9	10	11	12							
5													
6	18	17	16	15	14	13							
7													
8	19	20	21	22	23	24							
9													
10	30	29	28	27	26	25							
11													
12	31	32	33	34	35	36							
13													

NOTE: Not more than 4 corners, all in the same town and range, may be recorded on this certificate.

A. Description of original monument and accessories and/or subsequent restoration:

- July 20 1838 Noah Brookfield, GLO, "Set 1/4 Section post", Beech 12" S40°W 42 Links, Pine 30" N71°E 10 Links, (Page 92 - 93 Book 1)
- 1895 - 1896 Lyman W. June, County Surveyor, "Tile with bottle, Perpetuated by former County Surveyors"
- May 1903 Don B. Roben - old stake under stone, crockery (L2 - P252)
- 1979 Mueller #25861, LCRC (L1 - P474) Found 1/2" Iron 1' West of N-S Centerline & 8' South Centerline to East (Roosevelt Road), 30" Maple N80°W 26.81', 24" Oak N13°E 80.63', 20" Oak N37°E 57.77', Fence Post S57°E 36.74'
- July 23 1992 Duane F. Wood, # 24625 (L11 Pg.701) Found 3/4" Rerod, 30" Maple S65°E 58.79', 5" Maple N45° 73.84', Power Pole N70°W 50.87'

APPROVED BY MECOSTA CO. PEER GROUP
IN ACCORDANCE WITH P.A. 345 of 1990


James M. Knapp
CHAIRMAN
DATE MAY 18, 1995

B. Description of corner evidence found and/or method applied in restoring or reestablishing corner:

- January 26 1995, James J. Keller #10693 Found Iron in Tile fragments 1" deep surrounded by nest of stones; 0.90" deep found glass and charcoal surrounding iron. At 1.5' deep found clay tile along side base Iron. Inside tile were the remains of a wood stake; Nothing was found below the tile. Witnessed to tile.
- Set Pk nail in South Side Gate Post S37°W 45.13'
- Set 60d North Side 24" Maple N80°W 27.62'
- Set 60d East side 16" Oak N37W 63.54'
- Found 16d South East side 26" Oak N31°E 57.71'

C. Description of monument for corner and accessories established to perpetuate locating the position of the corner:

- Set Remonumentation Monument and accepted as a careful and faithful perpetuation of the position of the original corner.
- Set Pk nail and tag in South Side Gate Post S37°W 45.13'
- Set 60d and tag North Side 24" Maple N80°W 27.62'
- Set 60d and tag East side 16" Oak N37W 63.54'
- Found 16d and set tag South East side 26" Oak N31°E 57.71'

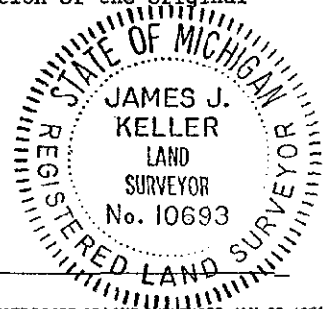

Signed by James J. Keller Date 27 June 1995

Surveyor's Michigan License No. 10693