

**SURVEY &
REMONUMENTATION**

MECOSTA COUNTY REMONUMENTATION PROGRAM

APR 04 1996

CORNER APPROVED BY PEER GROUP ON MAY 18, 1995

COMMISSION

LAND CORNER RECORDATION CERTIFICATE

Filing Requirement of Act 74, Mich. P.A. 1970

Joanne Brown
Register of Deeds
Mecosta County

'95 NOV -2 AM 11:13

For corners in

| <u>Mecosta</u> (County) | Located In: | Corner Code # |
|---------------------------------------|---------------------------------|---------------|
| 1. Public Land Survey | Sec 14 T <u>15N</u> R <u>7W</u> | <u>J-7</u> |
| | T _____ R _____ | _____ |
| | T _____ R _____ | _____ |
| | T _____ R _____ | _____ |
| 2. Property Controlling in Section | S _____ T _____ R _____ | _____ |
| | S _____ T _____ R _____ | _____ |
| 3. Miscellaneous Property in Sec. | S _____ T _____ R _____ | _____ |
| | S _____ T _____ R _____ | _____ |

Register of Deeds Stamp & File Number

4. Lot No. _____, Recorded Plat _____
5. Private Claims _____

I, James J. Keller, in a field survey on January 26 19 95, do hereby certify that under requirements of P.A. 74, Michigan P.A. of 1970, the corner points mentioned in lines 1 and 2 above were in conformance with regulations and rules therefore as required in the current manual of survey instructions of the United States Department of the Interior, Bureau of Land Management or by a decree of a Court of Law and/or that the corner points mentioned in lines 3, 4 and 5 above were in conformance with the rules of the Michigan Board of Land Surveyors or by a Decree of a Court of Law; established, re-established, monumented, re-monumented, recovered, found as expressed below:

NOTE: Not more than 4 corners, all in the same town and range, may be recorded on this certificate.

A. Description of original monument and accessories and/or subsequent restoration:

1839 Noah Brookfield, Deputy Surveyor, GLO notes, Birch 12" is 1/4 corner
1895-96, Lyman W. June, County Surveyor, " Old stake" Hemlock 10" West 56 Links
1915 Walter Willets, County Surveyor, Found Iron, Pine 4" S45°E 59 links
December 15, 1938, W. H. Wright; County Surveyor, Road Survey, "Found Tile" (See Road Plan - profile)

APPROVED BY MECOSTA CO. PEER GROUP
IN ACCORDANCE WITH P.A. 345 of 1990

James J. Knapp
CHAIRMAN
DATE MAY 18, 1995

B. Description of corner evidence found and/or method applied in restoring or reestablishing corner:


January 26, 1995; James J. Keller #10693, Found clay tiles- Top tile broken; Second tile 14" deep; a third tile was found at a depth of 2.25' with charcoal and remains of wood stake. Set 1/2" x 18" Rebar & Cap in center 3" deep. 2' East of centerline of two-track North-South.

- Set 60d East side 9" Maple N35°W 27.16'
- Set 60d South side Twin 18" Maple N41°E 21.76'
- Set 30d South side 18" Maple with fence wire S85°E 55.55'
- Set 60d West Side 18"-18"-24" Maple S20°E 12.54'

C. Description of monument for corner and accessories established to perpetuate locating the position of the corner:

Set Remonumentation Monument in place of rebar and cap and is accepted as a careful and faithful perpetuation of the position of the original corner.

- Set 60d and tag East side 9" Maple N35°W 27.16'
- Set 60d and tag South side Twin 18" Maple N41°E 21.76'
- Set 60d and tag South side 18" Maple with fence wire S85°E 55.55'
- Set 60d and tag West Side 18"-18"-24" Maple S20°E 12.54'

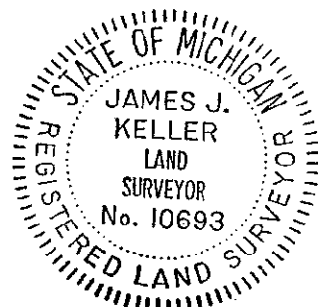

Signed by James J. Keller Date 27 June 1995

Surveyor's Michigan License No. 10693