

SURVEY & REMONUMENTATION
MECOSTA COUNTY REMONUMENTATION PROGRAM

NOV 18 1997

CORNER APPROVED BY PEER GROUP ON DECEMBER 13, 1996

LAND CORNER RECORDATION CERTIFICATE

COMMISSION

Filing Requirement of Act 74, Mich. P.A. 1970

For corners in

MECOSTA
(County)

Located in:

Corner Code #

STATE OF MICHIGAN
 COUNTY OF MECOSTA
 RECEIVED FOR RECORD

'97 NOV -7 P2:24

Jessie Brown
 REGISTER OF DEEDS
 Register of Deeds Stamp & File Number

1. Public Land Survey	T	15N	R	08W	G-13
	T		R		
	T		R		
	T		R		
2. Property Controlling in Section	S	T	R		
	S	T	R		
3. Miscellaneous Property in Sec.	S	T	R		
	S	T	R		

4 Lot No. _____ Recorded Plat _____
 5. Private Claims _____

	A	B	C	D	E	F	G	H	I	J	K	L	M
2	6	5	4	3	2	1							
3													
4	7	8	9	10	11	12							
5													
6	18	17	16	15	14	13							
7													
8	19	20	21	22	23	24							
9													
10	30	29	28	27	26	25							
11													
12	31	32	33	34	35	36							
13													

I, JACK E. PIERSON in a field survey on OCTOBER 30, 1996, do hereby certify that under requirements of P.A. 74, Michigan P.A. of 1970, the corner points mentioned in lines 1 and 2 above were in conformance with regulations and rules therefore as required in the current manual of survey instructions of the United States Department of the Interior, Bureau of Land Management or by a decree of a Court of Law and/or that the corner points mentioned in lines 3, 4 and 5 above were in conformance with the rules of the Michigan Board of Land Surveyors or by a Decree of a Court of Law; established, re-established, monumented, re-monumented, recovered, found as expressed below:

NOTE: Only one corner may be recorded on this certificate.

A. Description of original monument and accessories and/or subsequent restoration:

DEPUTY SURVEYOR, JOHN HODGSON, SET POST ON SEPTEMBER 22, 1837, AND WITNESSED:
 18" PINE S48°W 25 LINKS
 14" BEECH N78°E 22 LINKS

IN 1896, LYMAN W. JUNE, COUNTY SURVEYOR, WAS APPOINTED BY THE MARTINY TOWNSHIP BOARD TO PERPETUATE THE GOVERNMENT SURVEY CORNERS IN T15N-R8W, AS RECORDED IN COUNTY SURVEYORS RECORD BOOK NO. 1, PAGES 290 AND 291. CORNER IS WITNESSED AS:
 PINE STUMP 20" N48°W 25 LINKS = O.B.T.
 PINE STUMP 24" NORTH 5 LINKS

COUNTY SURVEYOR RECORD BOOK NO. 1, PAGE 58 AT REGISTER OF DEEDS OFFICE SHOW NOTES BY L.W. JUNE, COUNTY SURVEYOR, ON MAY 5, 6, 7, 1898, CORNER NOTED AS, "TILE CORNER 10 L. WEST OF COR. FOR 3 & 4".

ROAD SURVEY NOTES AT THE MECOSTA COUNTY ROAD COMMISSION BY E. E. SCURS, COUNTY ENGINEER, DATED APRIL 20, 1927, TO BE AT STATION 51+208 FROM CORNER COMMON TO SECTIONS 3, 4, 9, AND 10, AND BEING "TILE - 10 L. W. OF COR. FOR 3 & 4".

CORNER USED BY JERRY TAYLOR, P.S. AND WITNESSES:

18" W. PINE	N35°E,	90.3 FEET
20" W. PINE	S70°E,	36.55 FEET
2" W. PINE	S35°W,	49.65 FEET
32" W. PINE	N55°W,	62.35 FEET

CORNER USED BY WILLIAM TINGLEY, P.S. 30104

APPROVED BY MECOSTA CO. PEER GROUP
 IN ACCORDANCE WITH P.A. 345 of 1990

James J. Knapp
 CHAIRMAN
 DATE DEC. 13, 1996

B Description of corner evidence found and /or method applied in restoring or reestablishing corner

FOUND R.R. SPIKE AT LOCATION IN SOUTHBOUND LANE OF 90TH AVENUE 6.6 FEET WEST OF R.R. SPIKE ON CENTERLINE. LOCATION HAS BEEN FILLED AND NO OTHER EVIDENCE WAS FOUND UNDER SPIKE. LOCATION AGREES WITH L. W. JUNE, COUNTY SURVEYOR, DISTANCE GIVEN TO QUARTER CORNER TO THE EAST. CORNER HAS BEEN USED TO PERFORM VARIOUS SURVEYS AND IS CONSIDERED THE CORNER BY COMMON REPORT.

C. Description of monument for corner and accessories established to perpetuate locating the position of the corner:

G-13 - SECTION CORNER COMMON TO SECTIONS 33 AND 34, T15N-R08W
 FOUND RAILROAD SPIKE AND IS ACCEPTED AS A CAREFUL AND FAITHFUL RE-ESTABLISHMENT OF THE POSITION OF THE ORIGINAL CORNER.


REMOVED THE RAILROAD SPIKE AND SET IN THE SAME POSITION A STANDARD MECOSTA COUNTY REMONUMENTATION MONUMENT AND HIGHWAY MONUMENT BOX.

SET 60d SPIKE W/REMONUMENTATION TAG IN	24" WHITE PINE	AZ. 112°,	36.90 FEET
SET 60d SPIKE W/REMONUMENTATION TAG IN	10" RED PINE	AZ 148°,	85.38 FEET
SET 60d SPIKE W/REMONUMENTATION TAG IN	24" WHITE PINE	AZ 37°,	70.63 FEET
N.W. CORNER SECTION 3, T14N-R08W (MECOSTA COUNTY REMONUMENTATION MONUMENT)		EAST	6.64 FEET

Signed by Jack E. Pierson

Date AUGUST 19, 1997

Surveyor's Michigan License No. 19305

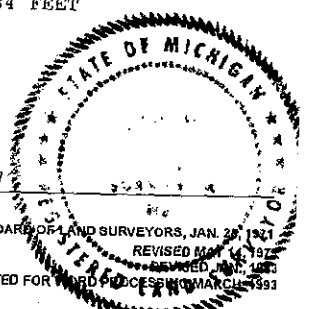

FORM APPROVED BY MICHIGAN STATE BOARD OF LAND SURVEYORS, JAN. 28, 1921
 REVISED MAY 14, 1973
 ADAPTED FOR WORD PROCESSING, MARCH 1993