

SURVEY & REMONUMENTATION
MECOSTA COUNTY REMONUMENTATION PROGRAM

JUL 06 1998

CORNER APPROVED BY PEER GROUP ON April 17, 1998

LAND CORNER RECORDATION CERTIFICATE

SECTION

Filing Requirement of Act 74, Mich. P.A. 1970

REGISTER'S OFFICE
 Mecosta County, } ss.

For corners in
Mecosta
 (County)

Located in:

Corner Code #

BIG RAPIDS TWP.

1. Public Land Survey	SEC 8	T 15N	R 10W	E-3
		T	R	
		T	R	
		T	R	
2. Property Controlling in Section	S	T	R	
	S	T	R	
3. Miscellaneous Property in Sec.	S	T	R	
	S	T	R	

Received for Record, the 29
 day of June A.D., 1998
 at 3:15 o'clock P. M., and Recorded
 in Liber _____ of _____
 on Page _____

Joanne Brown
 Register of Deeds
 Mecosta County
Register of Deeds Stamp & File Number

4. Lot No. _____, Recorded Plat _____
 5. Private Claims _____

	A	B	C	D	E	F	G	H	I	J	K	L	M
1													
2	6	5		4		3		2		1			
3													
4	7	8		9		10		11		12			
5													
6	18	17		16		15		14		13			
7													
8	19	20		21		22		23		24			
9													
10	30	29		28		27		26		25			
11													
12	31	32		33		34		35		36			
13													

I, James J. Keller, in a field survey on April 13, 1998, do hereby certify that under requirements of P.A. 74, Michigan P.A. of 1970, the corner points mentioned in lines 1 and 2 above were in conformance with regulations and rules therefore as required in the current manual of survey instructions of the United States Department of the Interior, Bureau of Land Management or by a decree of a Court of Law and/or that the corner points mentioned in lines 3, 4 and 5 above were in conformance with the rules of the Michigan Board of Land Surveyors or by a Decree of a Court of Law; established, re-established, monumented, re-monumented, recovered, found as expressed below:

NOTE: Not more than 2 corners, all in the same town and range, may be recorded on this certificate.

A. Description of original monument and accessories and/or subsequent restoration:

- February 15, 1838, Abner E. VanNess, Deputy Surveyor G.L.O. "Set Post Cor. to Sect. 4, 5, 8 & 9" 8" Beech N73-1/2°E 13 Links (8.58') 6" Beech N55°W 9 Links (5.94')
- April 17, 1903, Don B. Roben, County Surveyor (Record Book 1, Page 126 & Field Book 6, Pages 42-43) "Old Stone Corner"
- W.H. Wright, Mecosta County Surveyor, Unrecorded Survey in West 1/2 Sec 9. No Witnesses Given and no Data
- W.H. Wright, Mecosta County Surveyor, Unrecorded Survey in NW 1/4 Sec 9. No Witnesses Given and no Data
- December 6, 1976, Douglas W. Hooth RLS #7966 MSHD (LCRC L1 P269) "Found Iron Rod 1/2" x 18" with Wood Stake & Pile of Stones 3' North of Ctr. of East-West Road, and in Ctr of Rd. South in Line with Fence to North Buried 8". Found From Survey Records" P.Pole S20°E 94.19' P.Pole S35°W 108.83' 12" Willow N76°W 110.86' Face 4" Steel Corner Fence Post Due North 38.45'
- Circa 1978, MSHD Section Breakdown Worksheet Shows Corner is N00°15'44"W 2655.262' From 1/4 Corner 8-9
- August 12, 1980, Edwin J. McCombs, RLS #10696 (Survey L10 P934) "1/2" Rerod" P.Pole S20°E 94.19' P.Pole S35°W 108.83' 12" Box Elder N76°W 110.86' St. Sign North 38.45'
- Circa 1992, Mecosta County Road Survey Shows Corner is 2615.76' West of N1/4 Corner Sec 9, and Gives Two Witnesses Spike in W side Utility Pole Az 165° 94.23' Pipe For Fence Corner Northerly 39'
- February 24, 1993, James J. Keller, RLS #10693 (Field Book 113-W, Page 49) "Found 1/2" Rebar 9" Deep (LCRC L1 P269)" 4" Iron Fence Post N03°E 38.29' Found MSHD Tag P.Pole S18°E 93.87' Found 30d P.Pole S36°W 108.48' Tel Box S70°W 112.24'
- April 8, 1993, James J. Keller, RLS #10693 (Survey Liber 11, Pages 645 & 646) "Found 1/2" Rebar 9" Deep (L1 P269)" 4" Pipe Fence Post N03°E 38.29' MSHD Tag P.Pole S18°E 93.87' Found 30d P.Pole S36°W 108.48' Tel Box S70°W 112.24'

B. Description of corner evidence found and/or method applied in restoring or reestablishing corner:


- April 13, 1998, James J. Keller, RLS #10693 (Field Book 138W, Page 56) "Found Cap 33139 on Rebar" South Face 4" IP Fence Post N03°E 38.51' Found MSHD Tag NE Side Distribution Pole S16°E 93.85' Found MSHD Tag NW Side Distribution Pole S37°W 108.98' Found Tag #33139 NW Side 12" Elm S43°W 66.67' Found Tag #33139 NE Side 12" Willow N30°W 28.84' Found 1/2" Rebar with Unreadable Cap Surrounded by Stones 22" Deep

C. Description of monument for corner and accessories established to perpetuate locating the position of the corner:

- Accepted Rebar 22" Deep & Set Remonumentation Monument in Box Over it as a Careful and Faithful Perpetuation of the Original Corner. South Face 4" IP Fence Post N03°E 38.43' Found MSHD Tag & Set 60d & Tag Over it SE side P.Pole S25°E 94.17' Found Tag #33139 & Set 60d & Tag Over it NW side 12" Elm S 45°W 66.70' Found MSHD Tag & Set 60d & Tag Above NW side P.Pole S36°W 109.14' Found Tag #33139 & Set 60d & Tag Above 12" Willow N31°W 28.90'

Signed by James J. Keller Date June 12, 1998

Surveyor's Michigan License No. 10693

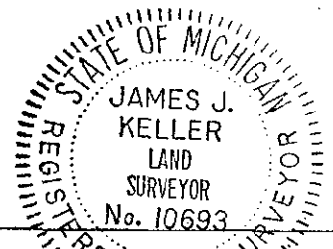

APPROVED BY MECOSTA CO. PEER GROUP
 IN ACCORDANCE WITH P.A. 74 OF 1970

FORM APPROVED BY MICHIGAN STATE BOARD OF LAND SURVEYORS, JAN. 28, 1971
 REVISED MAY 14, 1976
 REVISED JAN. 1983
 ADAPTED FOR WORD PROCESSING MARCH, 1993

LIBER **100** PAGE

422 James J. Knapp
 CHAIRMAN