

**SURVEY & REMONUMENTATION MECOSTA COUNTY REMONUMENTATION PROGRAM**

JUL 06 1998

**CORNER APPROVED BY PEER GROUP ON February 13, 1998**

**LAND CORNER RECORDATION CERTIFICATE**

Filing Requirement of Act 74, Mich. P.A. 1970

REGISTER'S OFFICE }  
Mecosta County, } ss.

**SECTION**

For corners in

Mecosta  
(County)

Located In:

BIG RAPIDS TWP.

Corner Code #

1. Public Land Survey	SEC 28	T 15N	R 10W	F-9
		T	R	
		T	R	
		T	R	
2. Property Controlling In Section	S	T	R	
	S	T	R	
3. Miscellaneous Property in Sec.	S	T	R	
	S	T	R	

Received for Record, the 29 day of June A.D., 1998 at 3:15 o'clock P.M., and Recorded in Liber \_\_\_\_\_ of \_\_\_\_\_ on Page \_\_\_\_\_

Register of Deeds  
*Joanne Brown*  
Register of Deeds  
Mecosta County  
Stamp & File Number

4. Lot No. \_\_\_\_\_, Recorded Plat \_\_\_\_\_  
5. Private Claims \_\_\_\_\_

I, James J. Keller, in a field survey on FEBRUARY 11, 19 98, do hereby certify that under requirements of P.A. 74, Michigan P.A. of 1970, the corner points mentioned in lines 1 and 2 above were in conformance with regulations and rules therefore as required in the current manual of survey instructions of the United States Department of the Interior, Bureau of Land Management or by a decree of a Court of Law and/or that the corner points mentioned in lines 3, 4 and 5 above were in conformance with the rules of the Michigan Board of Land Surveyors or by a Decree of a Court of Law; established, re-established, monumented, re-monumented, recovered, found as expressed below:

**NOTE: Not more than 2 corners, all in the same town and range, may be recorded on this certificate.**

A. Description of original monument and accessories and/or subsequent restoration:

- February 14, 1838, Abner E. VanNess, Deputy Surveyor G.L.O. "Set Qr. Sec Post"  
10" Beech S69°W 5 Links (3.30') 10" Ironwood S55°E 16 Links (10.56')
- July 23, 1925, E.E. Scours, Mecosta County Road Survey "Iron Rod & Stone"  
16" W. Pine SW 122.5' 10" Elm NW 45.2'
- December 26-27-28, 1935, W.H. Wright, Mecosta County Road Survey "Iron Stake 1/4 Cor"
- February 9, 1976, Douglas W. Hooth RLS #7966 MSHD (LCRC L1 P218) "Found 1" Iron Bar 19" Below Gravel Surface Raised with 3/4" Iron Pipe to 4" Below Gravel Surface & Int. 14 Mile Road & 215th Avenue"  
17" Pine S20°W 72.11' 16" Pine S65°W 72.16'  
28" Pine N20°W 64.93' Face Conc. Fence Post S40°E 40.35'
- September 25, 1984, Duane F. Wood RLS #24625 (Survey L11 P297) "Found 3/4" Pipe"  
17" Pine S20°W 72.11' 16" Pine S65°W 72.16 28" Pine N20°W 64.93'
- January 23, 1990, Duane F. Wood RLS #24625 (Survey L11 P902-903-904 and Countersigned by Gerald J. Gray RLS #17741 on April 11, 1995) "3/4" Iron Pipe"  
17" Pine Az 200° 72.11' 16" Pine Az 245° 72.16'  
28" Pine Az 340° 64.93' Face Conc. Fence Post Az 140° 40.35'

B. Description of corner evidence found and/or method applied in restoring or reestablishing corner:

February 11, 1998, James J. Keller RLS #10693 (Field Book 138W, Page 52) "Found 3/4" IP With Top 6" Bent East in C/L 2 track West"  
Found MSHD Tag E side 42" White Pine N16°W 64.67'  
Set PK Nail SE side P.Pole N57°E 46.53'  
NW Face 14" Dia. Conc. Post 5' High S37°E 40.70'  
Set 60d NW side 18" White Pine S63°W 72.16'

C. Description of monument for corner and accessories established to perpetuate locating the position of the corner:


Accepted Pointed 6"x7"x8" Stone and Set Remonumentation Monument in Place of it as a Careful and Faithful Perpetuation of the Original Corner (No Iron Found)  
  
Found 3/4" IP 1' in ground & 6" Bent Flat Above Ground 0.38'S of 0.20'W of Stone  
Found MSHD Tag and Set 60d and Tag Above E side 42" White Pine N15°W 64.35'  
Found PK Nail & Set Tag SE side P.Pole N60°E 46.17'  
Conc. Post-Gone June 1, 1998  
Set 60d & Tag W Side P.Pole S18°W 136.01'  
Found 60d & Set Tag NW side 18" White Pine S65°W 72.54'

A	B	C	D	E	F	G	H	I	J	K	L	M
1												
2	6	5	4	3	2	1						
3												
4	7	8	9	10	11	12						
5												
6	18	17	16	15	14	13						
7												
8	19	20	21	22	23	24						
9												
10	30	29	28	27	26	25						
11												
12	31	32	33	34	35	36						
13												

APPROVED BY MECOSTA CO. PEER GROUP IN ACCORDANCE WITH P.A. 345 of 1990  
*James J. Keller*  
CHAIRMAN  
DATE FEB. 13, 1998

Signed by James J. Keller Date June 1, 1998

Surveyor's Michigan License No. 10693

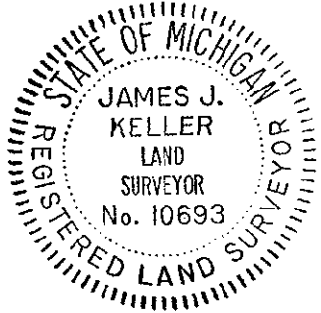


SURVEY &  
REMONUMENTATION

JUL 06 1998

SECTION

6-1-1998

JJK LSH

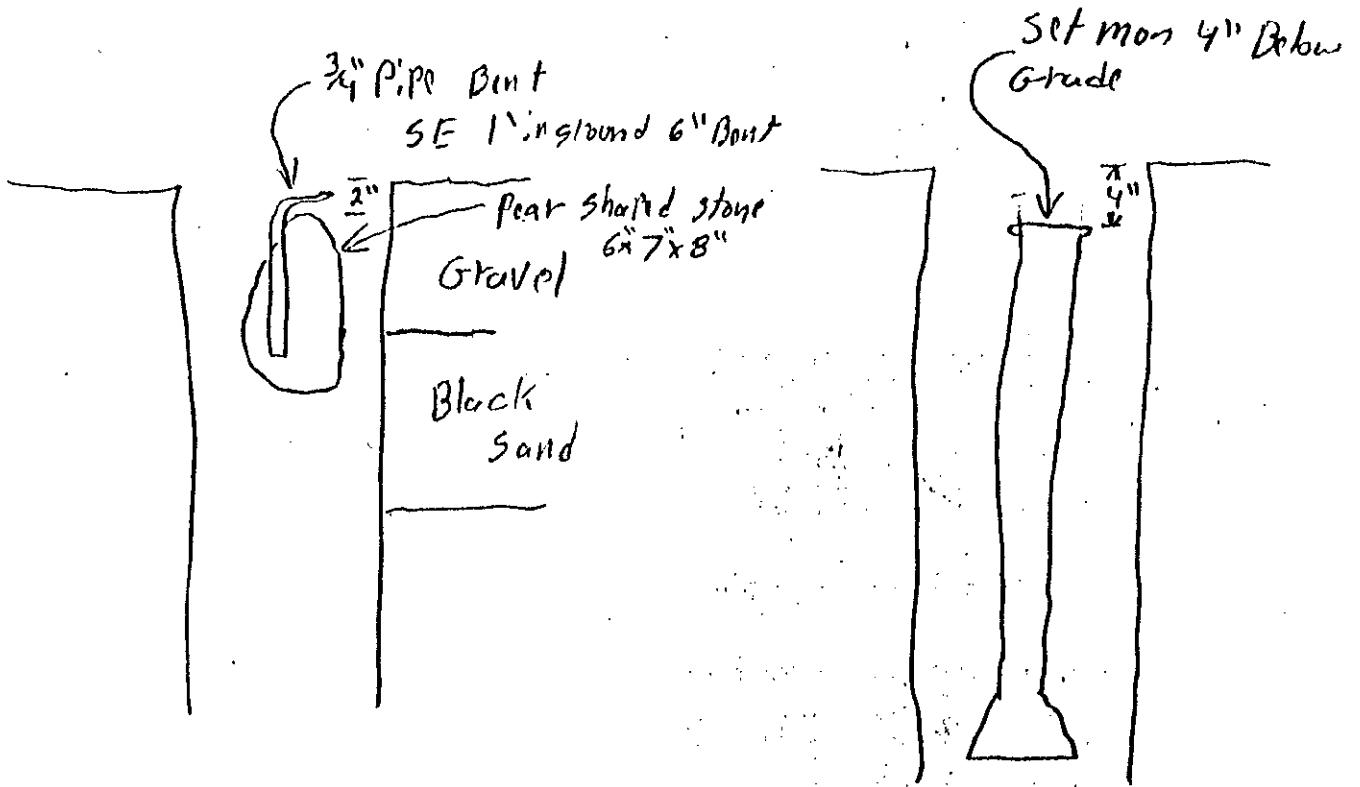

as Found

as set

