

SURVEY &  
REMONUMENTATION

JUL 06 1998 MECOSTA COUNTY REMONUMENTATION PROGRAM

CORNER APPROVED BY PEER GROUP ON April 17, 1998

SECTION

LAND CORNER RECORDATION CERTIFICATE REGISTER'S OFFICE

Filing Requirement of Act 74, Mich. P.A. 1970 Mecosta County, } 69.

For corners in <u>Mecosta</u> (County)	Located In: <u>Big Rapids Twp.</u>	Corner Code # <u>F-10</u>
1. Public Land Survey	SEC 28 T 15N R 10W	<u>F-10</u>
	T _____ R _____	_____
	T _____ R _____	_____
	T _____ R _____	_____
2. Property Controlling in Section	S _____ T _____ R _____	_____
	S _____ T _____ R _____	_____
3. Miscellaneous Property in Sec.	S _____ T _____ R _____	_____
	S _____ T _____ R _____	_____
4. Lot No. _____, Recorded Plat _____		
5. Private Claims _____		

Received for Record, the 29  
day of June A.D., 1998  
at 3:15 o'clock P.M., and Recorded  
in Liber \_\_\_\_\_ of \_\_\_\_\_  
on Page \_\_\_\_\_

*Joanne P. Stewart*  
Register of Deeds  
Mecosta County

Register of Deeds Stamp & File Number

	A	B	C	D	E	F	G	H	I	J	K	L	M
1													
2	6	5	4	3	2	1							
3													
4	7	8	9	10	11	12							
5													
6	18	17	16	15	14	13							
7													
8	19	20	21	22	23	24							
9													
10	30	29	●	27	26	25							
11													
12	31	32	33	34	35	36							
13													

I, James J. Keller, in a field survey on March 31, 1998, do hereby certify that under requirements of P.A. 74, Michigan P.A. of 1970, the corner points mentioned in lines 1 and 2 above were in conformance with regulations and rules therefore as required in the current manual of survey instructions of the United States Department of the Interior, Bureau of Land Management or by a decree of a Court of Law and/or that the corner points mentioned in lines 3, 4 and 5 above were in conformance with the rules of the Michigan Board of Land Surveyors or by a Decree of a Court of Law; established, re-established, monumented, re-monumented, recovered, found as expressed below:

NOTE: Not more than 2 corners, all in the same town and range, may be recorded on this certificate.

A. Description of original monument and accessories and/or subsequent restoration:

Not Set By GLO

B. Description of corner evidence found and/or method applied in restoring or reestablishing corner:

Circa 1975 MSHD Road Plans Control Section F 54014 Job No. 02612A Show Traverse Point in Fence West & 33' East of East End of Fence.  
Distant 2620.50' From S 1/4 Corner & 2693.37' From N 1/4 Corner With a Deflection Angle of 00°20'36"  
No Witnesses Given

May 17, 1988, Duane F. Wood RLS #24625 "Set 1/2" Steel Bar With ID Cap At Intersection of 1/4 Lines"  
P. Pole N 25°E 62.40' 14" Oak N80°W 45.95'  
10" Poplar N30°W 46.45' 6" Maple S30°W 58.30'


May 20, 1996 Gerald J. Gray RLS #17741 (Survey L12 P158 & 159) "Found 1/2" Iron"  
P. Pole N 25°E 62.40' 14" Oak N80°W 45.95' 10" Aspen N30°W 46.45'  
8" Ash S30°W 58.30' 1/2" Iron (MDOT Center) South 43.48'

March 31, 1998, James J. Keller RLS #10693 (Field Book 138W, Page 55) "Found 1/2" Rebar 1.5' East of CL and 4" Deep"  
Found 40d SW Side 16" Oak N71°W 45.80' Found 40d W Side P.Pole N34°E 62.40'  
Set 30d S Side 10" Red Pine S77°E 74.29' Set 30d SE Side 10" Ash S35°W 58.15'  
Found Cap #17741 N85°W 32.95' Found 1/2" Rebar 2" Deep S02°W 43.53'

C. Description of monument for corner and accessories established to perpetuate locating the position of the corner:

Accepted Rebar & Set Remonumentation Monument over it as a Careful and Faithful Perpetuation of the Corner

Found 40d & Set 60d & Tag above SW side 16" Oak N71°W 45.81'  
Found 40d & Set EK Nail & Tag above W side P.Pole N34°E 62.41'  
Found 30d & Replaced with 60d & Tag S side 10" R. Pine S77°E 74.29'  
Found 30d & Replaced with 60d & Tag SE side 10" Ash S35°W 58.15'

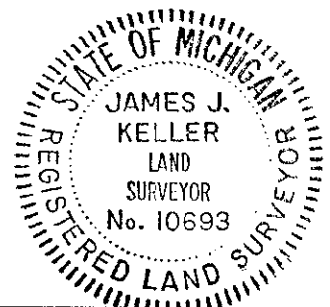

Signed by James J. Keller Date June 1, 1998

Surveyor's Michigan License No. 10693

FORM APPROVED BY MICHIGAN STATE BOARD OF LAND SURVEYORS, JAN. 28, 1974

APPROVED BY MECOSTA CO. PEER GROUP  
IN ACCORDANCE WITH P.A. 345 of 1990

REVISED MAY 14, 1976

ADAPTED FOR WORD PROCESSING MARCH, 1993


LIBER 100 PAGE 416  
James J. Knapp  
CHAIRMAN  
DATE APRIL 17, 1998

JUL 06 1998

6-1-98

SECTION

JJK LJH

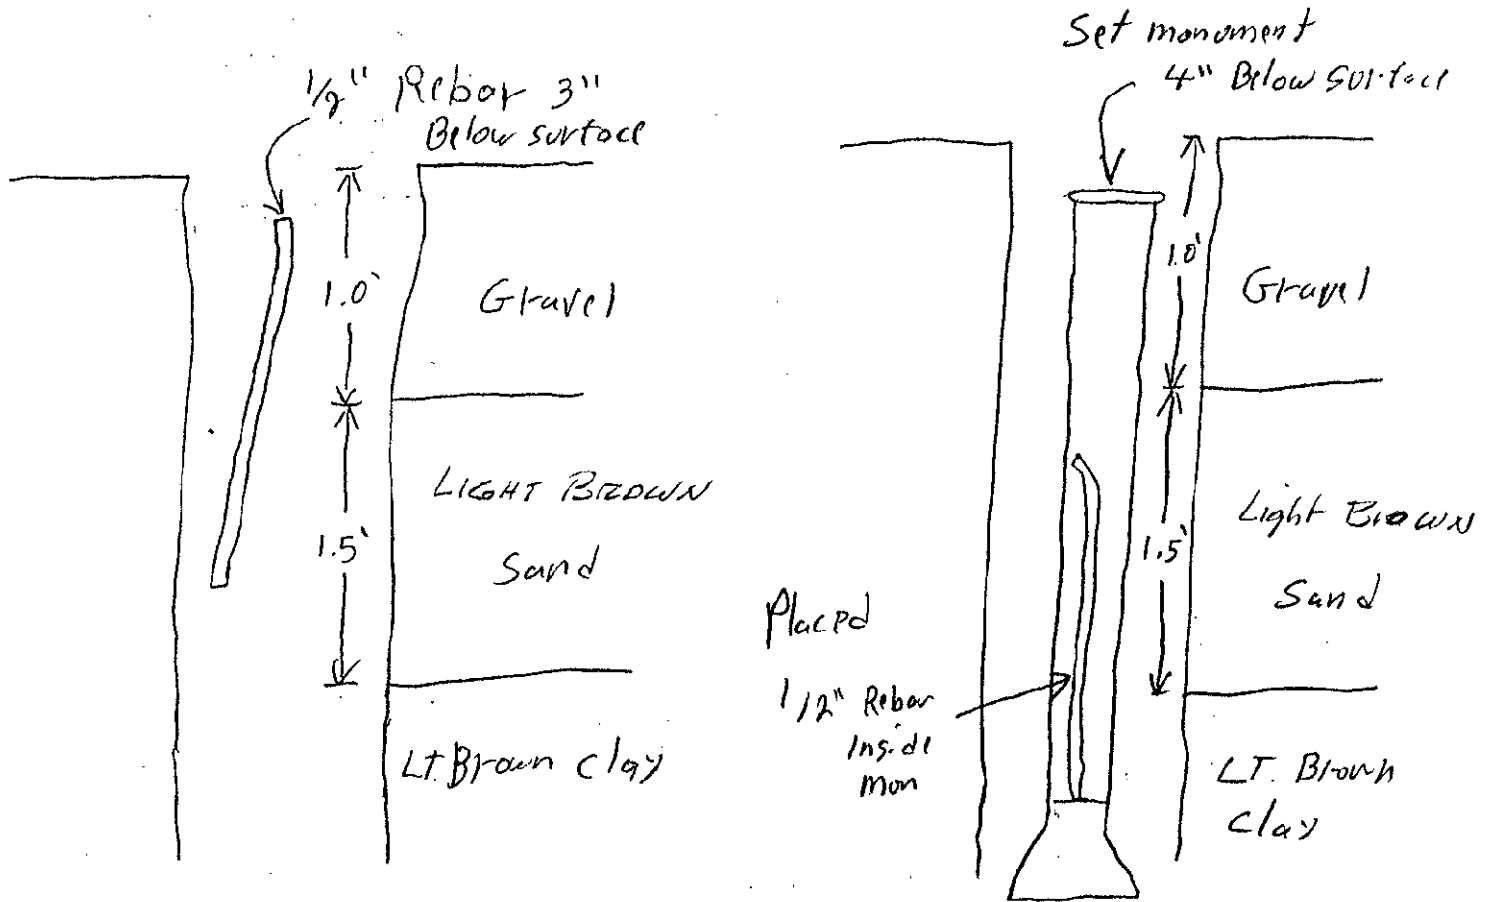

as Found

as set