

Survey  
REMONUMENTATION

NOV 18 1997

COMMISSION

# MECOSTA COUNTY REMONUMENTATION PROGRAM

CORNER APPROVED BY PEER GROUP ON August 8, 1997

## LAND CORNER RECORDATION CERTIFICATE

Filing Requirement of Act 74, Mich. P.A. 1970

STATE OF MICHIGAN  
COUNTY OF MECOSTA  
RECEIVED FOR RECORD

For corners in <u>Mecosta</u> (County)	Located In: <u>Big Rapids Township</u>	Corner Code # <u>J-13</u>
1. Public Land Survey	SEC 35 T15N R10W	<u>J-13</u>
	T _____ R _____	_____
	T _____ R _____	_____
	T _____ R _____	_____
2. Property Controlling in Section	S _____ T _____ R _____	_____
	S _____ T _____ R _____	_____
3. Miscellaneous Property in Sec.	S _____ T _____ R _____	_____
	S _____ T _____ R _____	_____
4. Lot No. _____, Recorded Plat _____		
5. Private Claims _____		

'97 SEP -5 P12:25

*James J. Keller*  
REGISTER OF DEEDS

Register of Deeds Stamp & File Number

I, James J. Keller, in a field survey on Sept-Oct. 19 96, do hereby certify that under requirements of P.A. 74, Michigan P.A. of 1970, the corner points mentioned in lines 1 and 2 above were in conformance with regulations and rules therefore as required in the current manual of survey instructions of the United States Department of the Interior, Bureau of Land Management or by a decree of a Court of Law and/or that the corner points mentioned in lines 3, 4 and 5 above were in conformance with the rules of the Michigan Board of Land Surveyors or by a Decree of a Court of Law; established, re-established, monumented, re-monumented, recovered, found as expressed below:

A	B	C	D	E	F	G	H	I	J	K	L	M
1												
2	6	5	4	3	2	1						
3												
4	7	8	9	10	11	12						
5												
6	18	17	16	15	14	13						
7												
8	19	20	21	22	23	24						
9												
10	30	29	28	27	26	25						
11												
12	31	32	33	34	35	36						
13												

NOTE: Not more than 4 corners, all in the same town and range, may be recorded on this certificate.

A. Description of original monument and accessories and/or subsequent restoration:

September 26, 1937, John Hodgson, Deputy Surveyor G.L.O. "Set Qr. Section Post"  
18" Beech N6°E 37 Links = 24.42 feet  
6" Beech N32°W 18 Links = 11.88 feet

March 21-23, 1915, Walter Willits, Mecosta County Surveyor "Iron"  
10" Maple S68°E 71' 6" Elm N21°W 36'

Nov. 29, 1988, Gerald J. Gray #17741, " (L.C.R.C. Liber 2, Page 241) "Found 1" Iron Bar in Monument Box"  
14" Maple Az. 316° 49.56'  
14" Maple Az. 295° 86.48'  
6" Thornapple Az. 180° 53.37'  
Capped Iron East 6.39' N. 1/4 Cor. Sec. 2

B. Description of corner evidence found and/or method applied in restoring or reestablishing corner:

Nov. 20, 1996, James J. Keller #10693, "Found 1" Iron in Mon. Box"  
Found 30d NE side 26" Maple N40°W 50.32'  
West face test station marker S34°E 40.68'  
Found 30d W side 5" Ash South 47.25'  
Found 30d E. side Dead 36" Maple N62°W 86.40'  
Found 1/2" rebar East 6.2' & 1' South of C/L 12 Mile Road. (Closing North 1/4 Corner for 2-14-10)


APPROVED BY MECOSTA CO. PEER GROUP  
IN ACCORDANCE WITH P.A. 345 of 1990

*James J. Knapp*  
CHAIRMAN  
DATE Aug. 8, 1997

C. Description of monument for corner and accessories established to perpetuate locating the position of the corner:

Accept 1" x 18" Steel bar & set remonumentation monument in box as best evidence of the position of the original corner.

Set 60d & tag E side 36" dead Maple N62°W 86.27'  
Set 60d & tag NE side 26" Maple N40°W 50.04'  
Set PK nail & tag SW side P. Pole S43°E 198.89'  
Set 60d & tag W side 5" Ash South 47.21'  
Set PK nail & tag NW side P. Pole S50°W 98.69'  
Re monumentation monument in box East 6.39' (Closing North 1/4 Corner for 2-14-10)  
C/L 12 Mile Road North 1'

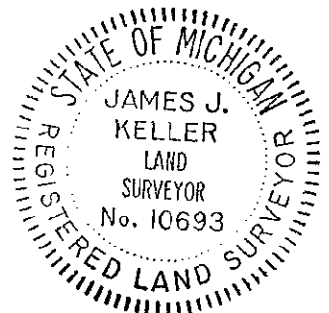

Signed by James J. Keller Date August 11, 1997

Surveyor's Michigan License No. 10693

FORM APPROVED BY MICHIGAN STATE BOARD OF LAND SURVEYORS, JAN. 28, 1971  
REVISED MAY 14, 1975  
REVISED JAN. 1983  
ADAPTED FOR WORD PROCESSING MARCH, 1983

NOV 18 1997


COMMISSION

JJK LJH

JUNE 9, 1997

↑  
N

as Found

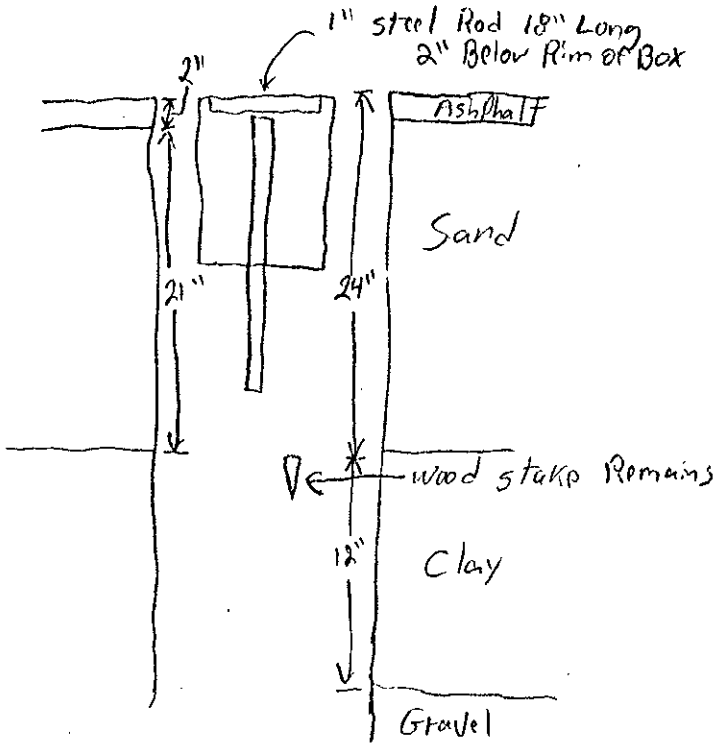

as set

