

MAY 05 1997

MECOSTA COUNTY REMONUMENTATION PROGRAM

CORNER APPROVED BY PEER GROUP ON November 21 1996

COMMISSION

LAND CORNER RECORDATION CERTIFICATE

Filing Requirement of Act 74, Mich. P.A. 1970

STATE OF MICHIGAN
COUNTY OF MECOSTA
RECEIVED FOR RECORD

For corners in

Mecosta
(County)

Located in:

Big Rapids Twp

Corner Code #

1. Public Land Survey	SEC 36	T15N	R10W	L-11
		T	R	
		T	R	
		T	R	
2. Property Controlling in Section	S	T	R	
	S	T	R	
3. Miscellaneous Property in Sec.	S	T	R	
	S	T	R	

'96 DEC 17 AM 1:31

Joann Brown
REGISTER OF DEEDS

Register of Deeds Stamp & File Number

4. Lot No. _____ Recorded Plat _____
5. Private Claims _____

I, James J. Keller, in a field survey on Sept-Oct 1996, do hereby certify that under requirements of P.A. 74, Michigan P.A. of 1970, the corner points mentioned in lines 1 and 2 above were in conformance with regulations and rules therefore as required in the current manual of survey instructions of the United States Department of the Interior, Bureau of Land Management or by a decree of a Court of Law and/or that the corner points mentioned in lines 3, 4 and 5 above were in conformance with the rules of the Michigan Board of Land Surveyors or by a Decree of a Court of Law; established, re-established, monumented, re-monumented, recovered, found as expressed below:

NOTE: Not more than 4 corners, all in the same town and range, may be recorded on this certificate.

A. Description of original monument and accessories and/or subsequent restoration:

Feb. 9, 1838, Abner E. VanNess, Deputy Surveyor G.L.O. "Set Qr. Sec. Post" Pine 36" Diam.

Dec. 4, 11, 12, 1914, Walter Willits, Mecosta County Surveyor Pine St. N80°W 21'

June 28, 1972, Patrick A. Salisbury #13594, (Liber 10, Page 59) "Found Iron" Nail 12" Cedar N10°W 13.37' Nail 22" Maple N37°E 38.67' Nail 10" Cedar S76°E 17.92'

March 24, 1975, Gerald J. Gray #17741, (L.C.R.C. Liber 1, Page 172 & 173) "Found 1" Sq. Iron" 12" Cedar N10°W 13.37' 22" Maple N37°E 38.67' 10" Cedar S76°E 17.92'

Oct. 8, 1978, Duane F. Wood #24625, (Liber 10, Page 665-67) "Found 1" Sq. Iron" 12" Cedar N10°W 13.37' 22" Maple N37°E 38.67' 12" Cedar S76°E 17.92'

April 13, 1983, Duane F. Wood #24625, (Unrecorded Survey) "Found 1" Sq. Steel Bar" 12" Cedar N10°W 13.37' 22" Maple N37°E 38.67' 10" Cedar S76°E 17.92'

B. Description of corner evidence found and/or method applied in restoring or reestablishing corner:

Aug. 8, 1995, James J. Keller #10693, (Unrecorded Survey) "Found 1" Sq. Iron" Found Nail & Set Nail W. side 16" Hemlock N08°W 13.82' Set Nail SE side 12" Oak N29°E 39.50' Found Nail SW side 30" Maple Stump N42°E 38.44' Found "V" Notch & Set Nail SE side 10" Hemlock N48°E 2.93' Found "V" Notch & Set Nail W. side 12" Hemlock S76°E 17.79'


APPROVED BY MECOSTA CO. PEER GROUP IN ACCORDANCE WITH P.A. 345 of 1990

James H. Knapp
CHAIRMAN
DATE Nov. 21, 1996

C. Description of monument for corner and accessories established to perpetuate locating the position of the corner:

Accepted 1" Square Iron supported by LGRC by Patrick A. Salisbury #13594, 1972 and set Remonumentation monument over 1" square iron as best evidence of original corner.

- Set 60d and tag W. side 16" Hemlock N09°W 13.83'
- Set 60d and tag SE. side 12" Oak N29°E 39.45'
- Set 60d and tag SE. Side 10" Hemlock N62°E 2.93'
- Set 60d and tag above nail N. side 12" Hemlock S74°E 18.40'
- Set 60d and tag above nail and tag SE. Side 30" Maple stump N40°E 39.87'

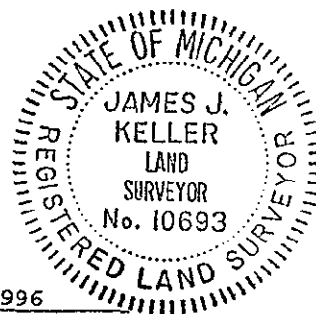

Signed by James J. Keller Date November 26, 1996

Surveyor's Michigan License No. 10693

11 - 26 - 1996 LJA

