

**SURVEY &
REMONUMENTATION**

MECOSTA COUNTY REMONUMENTATION PROGRAM

SEP 12 1996

CORNER APPROVED BY PEER GROUP ON April 15, 1996

COMMISSION

LAND CORNER RECORDATION CERTIFICATE

Filing Requirement of Act 74, Mich. P.A. 1970

STATE OF MICHIGAN
COUNTY OF MECOSTA
RECEIVED FOR RECORD

For corners in
Mecosta Located In: Corner Code #
(County)

'96 AUG 21 A10:32

1. Public Land Survey SEC 30 T 15N R 10W M-10 ✓
T 15N R 9W A-10
T R
T R
2. Property Controlling S T R
in Section S T R
3. Miscellaneous S T R
Property in Sec. S T R

Joanne Brown
REGISTER OF DEEDS

Register of Deeds Stamp & File Number

4. Lot No. _____, Recorded Plat _____
5. Private Claims _____

I, James J. Keller, in a field survey on May 8 1995,
do hereby certify that under requirements of P.A. 74, Michigan P.A. of 1970, the corner points mentioned
in lines 1 and 2 above were in conformance with regulations and rules therefore as required in the
current manual of survey instructions of the United States Department of the Interior, Bureau of Land
Management or by a decree of a Court of Law and/or that the corner points mentioned in lines 3, 4 and 5
above were in conformance with the rules of the Michigan Board of Land Surveyors or by a Decree of a
Court of Law; established, re-established, monumented, re-monumented, recovered, found as
expressed below:

	A	B	C	D	E	F	G	H	I	J	K	L	M
1													
2	6	5	4	3	2	1							
3													
4	7	8	9	10	11	12							
5													
6	18	17	16	15	14	13							
7													
8	19	20	21	22	23	24							
9													
10	30	29	28	27	26	25							
11													
12	31	32	33	34	35	36							
13													

NOTE: Not more than 4 corners, all in the same town and range, may be recorded on this certificate.

A. Description of original monument and accessories and/or subsequent restoration:

Sept 25, 1937 John Hodgson "Set 1/4 Post"
8" Black Oak S40°W 1.24 Links
7" Black Oak N31°W 53 Links

June 10, 1972 John David Henry #14875 (Liber 10, Page 51) Found 1½" Iron Pipe 37.6' East of Centerline Millpond Road.
P. Pole N07°W 54.95'
Mon. West 73.55'
Street Sign S01°W 37.9'

April 1986 John E McLane #28415 (Liber 11, Page 187) Found 1½" Pipe.
P. Pole N05°W 54.95'
Conc. Mon. West 73.55'
Street Sign S04°W 37.90'

May 28, 1986 Robert L. Wetherell #24624 (Liber 11, Page 623)
P. Pole N05°W 54.95' (Not Found)
Mon. West 73.55' (Found)
Sign S04°W 37.90' (Not Found)

APPROVED BY MECOSTA CO. PEER GROUP
IN ACCORDANCE WITH P.A. 345 of 1990

James J. Knapp
CHAIRMAN
DATE April 15, 1996


B. Description of corner evidence found and/or method applied in restoring or reestablishing corner:

May 2, 1995 James J. Keller #10693 Found 1-1/2"x3-1' Pipe 5" Deep, at 14" Found 3-3"x9-1/2" Clay Tiles
Bent IP in Conc. Mon. N86°W 73.50'
Set Nail East side 18" Cherry N14°W 151.44'
Set Nail South side 18" Oak S75°E 190.95'
Set Nail South side 8" Cherry S58°E 97.83'

C. Description of monument for corner and accessories established to perpetuate locating the position of the corner:

Set Remonumentation Monument and is accepted as careful perpetuation of the location of the original Monument.

Bent IP in Conc. Mon. N86°W 73.50'
Set 60d & Set tag East side 18" Cherry N14°W 151.44'
Set 60d & Set tag South side 18" Oak S75°E 190.95'
Set 60d & Set tag South side 8" Cherry S58°E 97.83'
Set 60d & Set tag North side Transformer Pole S63°W 120.08'

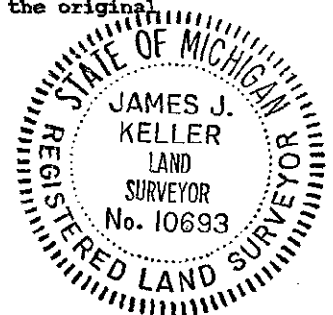

Signed by *James J. Keller*
Surveyor's Michigan License No. 10693

Date April 15, 1996

Set Mon 11/22/95

