LAND CORNER RECORDATION CERTIFICATE

Filing Requirement of Act 74, Mich. P.A. 1970

For corners in MECOSTA (County)

	Located In:	Corner Code ##
1. Public Land Survey	T 16N R 9W	C-13
	T ___ R ___	
	T ___ R ___	
	T ___ R ___	
2. Property Controlling	S 32 T ___ R ___	16
in Section	S ___ T ___ R ___	
3. Miscellaneous	S ___ T ___ R ___	
Property in Sec.	S ___ T ___ R ___	

Register of Deeds Stamp & File Number

4. Lot No. _____ , Recorded Plat _____
5. Private Claims _____

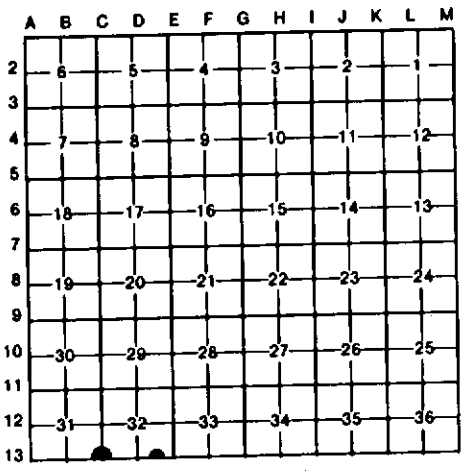

I, CARL F. ROSER, in a field survey on DECEMBER 17, 19 87, do hereby certify that under requirements of P.A. 74, Michigan P.A. of 1970, the corner points mentioned in lines 1 and 2 above were in conformance with regulations and rules therefore as required in the current manual of survey instructions of the United States Department of the Interior, Bureau of Land Management or by a decree of a Court of Law and/or that the corner points mentioned in lines 3, 4 and 5 above were in conformance with the rules of the Michigan Board of Land Surveyors or by a Decree of a Court of Law; established, re-established, monumented, re-monumented, recovered, found as expressed below:

NOTE: Not more than 4 corners, all in the same town and range, may be recorded on this certificate.

~~A. Description of original monument and accessories and/or subsequent restoration:~~

~~C-13~~ ~~C-13 CONT~~ ~~16~~

B. Description of corner evidence found and/or method applied in restoring or reestablishing corner:

C-13
RECOVERED OLD 1/2" IR ROD IN 3"VIT TILE FOR SW COR OF S-32; FITS L.W.JUNE WIT STUMP NW. SEE L.W.JUNE SUR OF S-32, DATED DEC 31, 1912-JAN 1,2,3,1913; CO SURVEYOR'S RECORD (FIELD BK) #9,PG'S 154-155, IN GREEN FILE CABINET DRAWER AT REG OF DEEDS. ALSO SEE SUR OF S 1/2 OF S-32 BY J.PIERSON, L.11,P.43; DATED

C-13 CONT
MAY 31, 1982. FD 1/2" ROD IN 3" VIT TILE, S88 11'20"W, 639.02 FOR NW COR OF S-5, T15N R9W. E EDGE OF SMALL POND IS 186'+8' N., W EDGE OF SMALL POND IS 345'±6' W.; OF SW S-32.

16
FD 1/2" ROD W/RLS CAP (J.PIERSON) FOR SE COR OF SW 1/4-SE 1/4 OF S-32. COR FALLS IN CTR OF E-W GRAVEL RD, ALSO CURVING SE'LY. OLD STUMP FN S'LY. IS 71'±E. Old B-W FN. S'LY IS 67"±E.

C. Description of monument for corner and accessories established to perpetuate locating the position of the corner:

C-13
FD OLD 1/2" IR ROD IN 3" VIT TILE FILLED W/CINDERS;ADDED CED POST W/LOC TAG.

*8" B CHERRY	N50 W	19.29
*6" W PINE	N75 E	3.67
*9" B CHERRY	S30 E	9.02
8" R OAK	S65 W	24.72
4" R OAK	N70 W	23.97
OLD E-W FN	DUE S	35'±1'
OLD FN W & N	DUE N	38'±3'

C-13 CONT
*EQUALS J.PIERSON'S WIT TREES (THE TWO B.CHERRY'S HE CALLED W OAKS)

16
FD 1/2" REROD W/RLS CAP.

4" TWIN MAPLE	N15 E	43.35
2" R PINE	S25 E	49.95
3" R PINE	S40 W	54.90
SET CED POST W/LOC TAG.	DUE N	40'
CTR 4"X4"X30" TALL TELE' RISER	N05 E	33.5'

Signed by Carl F. Roser 02/10/88 Date _____

Surveyor's Michigan License No. 12028

STATE OF MICHIGAN CARL F. ROSER LAND SURVEYOR No. 12028 REGISTERED LAND SURVEYOR

FORM APPROVED BY MICHIGAN STATE BOARD OF LAND SURVEYORS
REVISED JAN., 1975
REVISED JAN., 1983