LAND CORNER RECORDATION CERTIFICATE
Filing Requirement of Act 74, Mich. P.A. 1970

For corners in
MECOSTA (County)

	Located In:	Corner Code ##
1. Public Land Survey	T 16N R 09W	D-12
	T 16N R 09W	D-13
	T ___ R ___	
	T ___ R ___	
2. Property Controlling	S 32 T 16N R 09W	12.
in Section	S ___ T ___ R ___	
3. Miscellaneous	S ___ T ___ R ___	
Property in Sec.	S ___ T ___ R ___	

Register of Deeds Stamp & File Number

4. Lot No. _____ , Recorded Plat _____
5. Private Claims _____

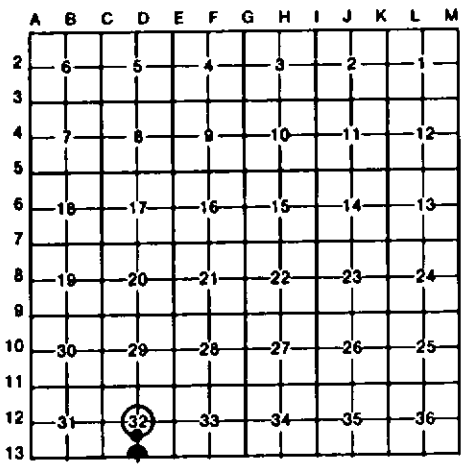

I, CARL F. ROSER, in a field survey on 12/17, 19 87, do hereby certify that under requirements of P.A. 74, Michigan P.A. of 1970, the corner points mentioned in lines 1 and 2 above were in conformance with regulations and rules therefore as required in the current manual of survey instructions of the United States Department of the Interior, Bureau of Land Management or by a decree of a Court of Law and/or that the corner points mentioned in lines 3, 4 and 5 above were in conformance with the rules of the Michigan Board of Land Surveyors or by a Decree of a Court of Law; established, re-established, monumented, re-monumented, recovered, found as expressed below:

NOTE: Not more than 4 corners, all in the same town and range, may be recorded on this certificate.

B. CONT'D.

D-13 ACCEPTED J.PIERSON S1/4 COR OF S.32 AS RESTORED @ REC 1913 L.W.JUNE DIST EAST OF FD TILE & IR. @ SW COR S.32. SEE L.W.J.(CO.SURV'S REC),BK 9,PGS.154-155(DEC.1912-JAN 1913) ALSO SEE J.PIERSON'S CERT.SUR OF S1/2 OF S.32,L.11,P.43,DATED MAY 31,1982. CTR. OF E-W GRAVEL RD.IS N 5' ±.

12 DROVE 5/8" X 34" REROD FOR NW CORNER OF SW-SE OF SEC.32.

B. Description of corner evidence found and/or method applied in restoring or reestablishing corner:

D-12 RESTORED CTR. OF S.32 PER L.W. JUNE SUR & S.SUB'N.OF S-32;DEC.31,1912-JAN.1-3,1913; SAID SUR REC IN CO SURS REC (FIELD BK)NO.9,PGS 154-155,IN GRN DRW CAB IN VAULT AT MECOSTA CO.REG OF DEEDS. WE FD L.W.J'S"BIG STONE ON LINE (E-W1/4LINE)ON W SD OF (ALMA)LAKE" & HIS E1/4 COR OF S.32; & ESTAB.CTR.OF S.32 @ PRORATED DIST BETWEEN W1/4 COR & E1/4 COR. TO L.W.J.DIST (5379' L.W.J.,5366.89' THIS SURV). WE THEN FINE-TUNED THE EASTING OF ABOVE CTR.S.32 POSITION 1.5'W TO BE ON LINE ACROSS J.PIERSON'S S1/4 COR & CTR S.32 (PER HIS SUR OF S1/2,S.32)PROJECTED N'LY TO INTERSECT ABOVE L.W.J.E-W1/4 LINE(J.PIERSON DID NOT HAVE L.W.J.E1/4,W1/4 OR STONE). PIERSON'S CTR. IS S01°20'05"W,61.11';SEE PIERSON'S CERT.SUR., L.11,P.43,DATED MAY 31,1982. WE WERE ABLE TO RECOVER THETILE & IR AT N1/4 COR OF S.32(AS NOTED IN L.W.J.NOTES),WHICH PUTS A LARGE DEFLECTION (N&S)@ CTR.OF S.32;HOWEVER, WERE WE TO RUN A STRAIGHT LINE N-S1/4 LINE, THE CTR WOULD MOVE 33'± W. THIS SURVEYOR IS NOT COMFORTABLE W/STRAIGHT LINE BET.1/4 COR'S TO SUBDIV SEC'S THAT HAVE ALREADY BEEN SUBDIV'D,STAKED & OCCUPIED MANY YEARS AGO(& OF RECORD); SO WE BASICALLY HAVE RETRACED & ACCEPTED L.W.J.SURV OF S.32,BY QRTR SECTIONS.(SEE SURVEY FILE & DRAWING'S FOR DETAILS).

C. Description of monument for corner and accessories established to perpetuate locating the position of the corner:

D-12

DROVE 5/8" X 34" REROD W/RLS CAP; SET CED POST W/LOC TAG.

11" ASH	S45°W	35.2'
9" RED OAK	S65°W	39.6'
3" RED OAK	DUE W	59.1'
CTR E-W GRRD	DUE S	59 '
FD 1/2" RE-ROD W/CAP	S01'20"E	61.11

D-13

FD 1/2" X 18" RE-ROD W/RLS CAP

*13" TW MAPLE	N15°W	27.68'
*11" MAPLE IN CLUMP 3	N50°E	44.39'
*13" R.OAK	S70°W	32.22'
FD 1/2" IR W/RLS CAP	DUE N	33.00'
SET CED POST W/LOC TAG	NORTH	33 '

*EQUALS PIERSON'S WIT.TREES

12

DROVE 5/8" X 34" REROD W/RLS CAP; SET CED POST W/LOC TAG

4" W.OAK	N50°E	19.3'
3" W.OAK	S30°E	9.4'
3" W.OAK	S85°W	8.7'
NE EDGE POND	DUE W	153'(±4')
FD J.PIERSON 1/2" REROD W/CAP	S01°27'E	30.5'

STATE OF MICHIGAN
CARL F. ROSER
LAND SURVEYOR
No. 12028
REGISTERED LAND SURVEYOR

Sign CARL F. ROSER Date Carl F. Roser 02/10/88

Surveyor Michigan License No. 12028

FORM APPROVED BY MICHIGAN STATE BOARD OF LAND SURVEYORS, JAN. 28, 1971
REVISED MAY 14, 1975
REVISED JAN., 1983