LAND CORNER RECORDATION CERTIFICATE

Filing Requirement of Act 74, Mich. P.A. 1970

For corners in
NECOBTA
(County)

	Located In:	Corner Code #/#
1. Public Land Survey	T 16 N R 9 W	E-10
	T ___ R ___	
	T ___ R ___	
	T ___ R ___	
2. Property Controlling	S 29 T ___ R ___	12
in Section	S 29 T ___ R ___	13
3. Miscellaneous	S 29 T ___ R ___	* = 680.7 W
Property in Sec.	S ___ T ___ R ___	OF CODE 14.

Register of Deeds Stamp & File Number

4. Lot No. _____ , Recorded Plat _____
5. Private Claims _____

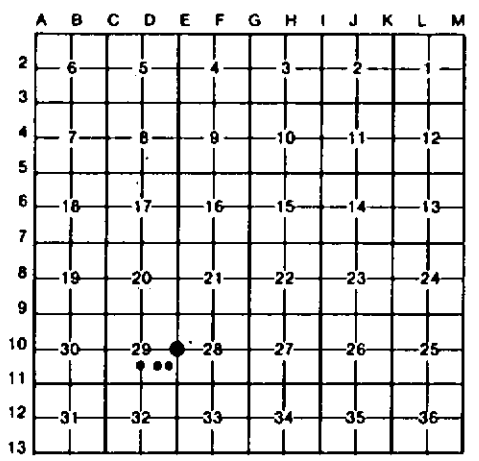

I, CARL F. ROSER, in a field survey on JANUARY 15TH, 19 88, do hereby certify that under requirements of P.A. 74, Michigan P.A. of 1970, the corner points mentioned in lines 1 and 2 above were in conformance with regulations and rules therefore as required in the current manual of survey instructions of the United States Department of the Interior, Bureau of Land Management or by a decree of a Court of Law and/or that the corner points mentioned in lines 3, 4 and 5 above were in conformance with the rules of the Michigan Board of Land Surveyors or by a Decree of a Court of Law; established, re-established, monumented, re-monumented, recovered, found as expressed below:

NOTE: Not more than 4 corners, all in the same town and range, may be recorded on this certificate.

A. Description of original monument and accessories and/or subsequent restoration:

E-10	12	13	*

B. Description of corner evidence found and/or method applied in restoring or reestablishing corner:

E-10	12	13	*
ACCEPTED FD. PK. NAIL, FLUSH IN CTR. N-S BIT. RD. AND IN LINE WITH CTR. OF DIRT RDS. TO E AND W; FOR E 1/4 OF S-29. RLS. W. BYL, COR. OF RECORD IN 1982 CALLED FOR 3/4" IRON BURIED 12". FD. 4 BYL WITS. THAT FIT.	ESTABILISH NE COR., SE 1/4, SW 1/4 OF S-29 PER STD. BLM INSTRUCTIONS.	ESTABILISH NE COR., SW 1/4, SE 1/4 OF S-29 PER STD. BLM INSTRUCTIONS.	ESTABILISH NE COR., W 1/2, SE 1/4, SE 1/4 OF S-29 PER STD. BLM INSTRUCTIONS.

C. Description of monument for corner and accessories established to perpetuate locating the position of the corner:

E-10			12			13			*		
FD. PK. NAIL.			DROVE 5/8"x 34" RE-ROD W/ RLS. CAP; SET CED. POST W/LOC. TAG.			DROVE 5/8"x 34" RE-ROD W/RLS. CAP; SET CED. POST W/ LOC. TAG			DROVE 5/8"x 34" RE-ROD W/RLS. CAP; SET CED POST W/ LOC TAG		
* 32"SUG.MAPLE	N30°W	53.2'									
* 32" SUG.MAPLE	N40°E	33.48'	4" MAPLE	N45°W	28.7'						
4" SPRUCE	N70°E	99.8'	11" W OAK	N65°E	41.4'	12" B CHERRY	N65°W	28.2'	4" MAPLE	N50°W	39.5'
CTR. 4" X 4"			3" MAPLE	S65°E	22.5'	3" MAPLE	S45°W	34.2'	1" MAPLE	N20°E	33.0'
MBT. PEDESTAL	S50°E	44.2'	3" MAPLE	S70°W	13.1'	16" MAPLE	S70°W	39.3'	4" MAPLE	S40°W	29.9'
						OLD E-W FN REMAINS	DUE N	30'±2'	OLD E-W FN. REMAINS	DUE N	35'±3'
									N'LY EDGE SWALE	DUE S	27'±5'

* = RLS. D. VERBA BTS.

Signed by Carl F. Roser 12-12-90 Date

Surveyor's Michigan License No. 12028

STATE OF MICHIGAN
CARL F. ROSER
LAND SURVEYOR
No. 12028
REGISTERED LAND SURVEYOR

ADOPTED BY MICHIGAN STATE BOARD OF LAND SURVEYORS, JAN. 28, 1971
REVISED MAY 14, 1975
REVISED JAN., 1983