LAND CORNER RECORDATION CERTIFICATE

Filing Requirement of Act 74, Mich. P.A. 1970

For corners in
MECOSTA
(County)

		Located In:	Corner Code ##
1. Public Land Survey		T 16 N R 9 W	B-9
		T ___ R ___	B-11
		T ___ R ___	
		T ___ R ___	
2. Property Controlling	S ___	T ___ R ___	
in Section	S ___	T ___ R ___	
3. Miscellaneous	S ___	T ___ R ___	
Property in Sec.	S ___	T ___ R ___	

Register of Deeds Stamp & File Number

4. Lot No. _____ , Recorded Plat _____
5. Private Claims _____

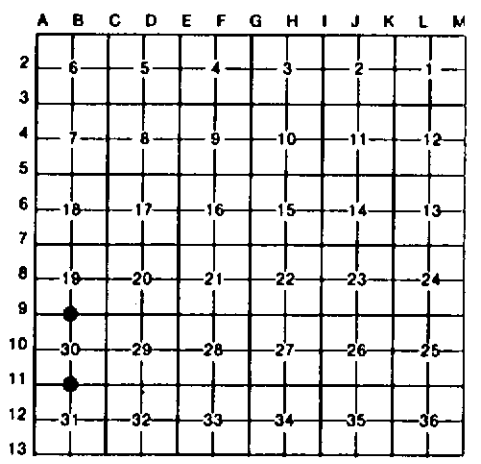

I, CARL F. ROSER, in a field survey on JANUARY 15TH, 19 88, do hereby certify that under requirements of P.A. 74, Michigan P.A. of 1970, the corner points mentioned in lines 1 and 2 above were in conformance with regulations and rules therefore as required in the current manual of survey instructions of the United States Department of the Interior, Bureau of Land Management or by a decree of a Court of Law and/or that the corner points mentioned in lines 3, 4 and 5 above were in conformance with the rules of the Michigan Board of Land Surveyors or by a Decree of a Court of Law; established, re-established, monumented, re-monumented, recovered, found as expressed below:

NOTE: Not more than 4 corners, all in the same town and range, may be recorded on this certificate.

A. Description of original monument and accessories and/or subsequent restoration:

B-9

B-9 CONT.

B-11

B. Description of corner evidence found and/or method applied in restoring or reestablishing corner:

B-9

FD. IRON ROD INSIDE TILES (VERT.) 2.5' DEEP (TOP TILE BROKE AND ROD BENT); STRAIGHTENED ROD AND DROVE 5/8" X 34" RE-ROD W/RLS. CAP INSIDE TILE AND ALONG SIDE ROD (TOP OF ROD IS 0.4' BELOW SURFACE OF GRAVEL ROAD INTERSECTION N-S-W). OLD COUNTY SURVEYORS RECORD (LARGE WHITE LIBER)CALLS FOR TILE-IRON, W. WILLITS APRIL 28,1915;

B-9 CONT.

E.E.SOURS 1919 AND LARGE LIBER, PG. 124; E.E.SOURS 1925.

B-11

ACCEPTED OLD 1/2" IRON ROD IN VIT. TILE FOR S 1/4 S-30. COR. IS BURIED 1' IN LINE W/ OLD PINE STP. FN. S'LY AND OLD WIRE FN. W'LY. COR. IS RLS, G. GREY, 1979 COR. OF RECORD . COR. IS DON B. ROBEN, CO. SURVEYOR, 1903 COR. OF RECORD; RECORDED ON PG. 124 OF LARGE LIBER W/OLD CO. SURVEY RECORDS AT REG. OF DEEDS.

C. Description of monument for corner and accessories established to perpetuate locating the position of the corner:

B-9

FD. TILES (VERT.) W/ ROD INSIDE; RAISED WITH 5/8" X 34" RE-ROD W/ RLS. CAP.

8" ELM	N60°W	21.32'
11" ELM	N45°E	44.33'
22" OAK	S15°W	105.63'
CTR. N-S GRV.RD.	DUE E	2'
CTR. GR.RD. E	DUE S	1'
SET CED. POST W/LOC. TAG.	DUE W	33'

B-9 CONT.

B-11

FD. OLD 1/2" IRON ROD IN 3" VIT. TILE; ADDED CED. POST W/LOC. TAG.

*16" W OAK	N70°W	32.61'
6" R OAK	N20°W	49.03'
*13" R OAK	N15°E	35.83'
12" R OAK	S60°E	46.93'

* = G. GREY, RLS. BT.

STATE OF MICHIGAN
CARL F. ROSER
LAND SURVEYOR
No. 12028
REGISTERED LAND SURVEYOR

Signed by Carl F. Roser 12-12-90 Date _____

Surveyor's Michigan License No. 12028

FORM APPROVED BY MICHIGAN STATE BOARD OF LAND SURVEYORS, JAN. 28, 1971
REVISED MAY 14, 1975
REVISED JAN., 1983