LAND CORNER RECORDATION CERTIFICATE

Filing Requirement of Act 74, Mich. P.A. 1970

For corners in
MECOSTA
(County)

	Located In:	Corner Code ##
1. Public Land Survey	T 16 N R 9 W	D-10
	T ___ R ___	E-9
	T ___ R ___	
	T ___ R ___	
2. Property Controlling	S 29 T ___ R ___	9
in Section	S ___ T ___ R ___	
3. Miscellaneous	S 29 T ___ R ___	* = 685.9 W
Property in Sec.	S ___ T ___ R ___	OF E-11.

Register of Deeds Stamp & File Number

4. Lot No. _____ , Recorded Plat _____
5. Private Claims _____

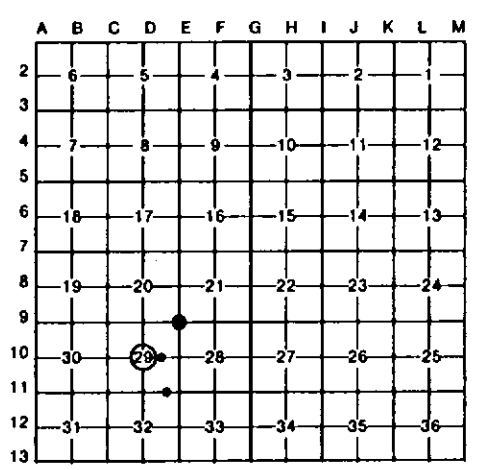

I, CARL F. ROSER , in a field survey on JANUARY 15 , 19 89 , do hereby certify that under requirements of P.A. 74, Michigan P.A. of 1970, the corner points mentioned in lines 1 and 2 above were in conformance with regulations and rules therefore as required in the current manual of survey instructions of the United States Department of the Interior, Bureau of Land Management or by a decree of a Court of Law and/or that the corner points mentioned in lines 3, 4 and 5 above were in conformance with the rules of the Michigan Board of Land Surveyors or by a Decree of a Court of Law; established, re-established, monumented, re-monumented, recovered, found as expressed below:

NOTE: Not more than 4 corners, all in the same town and range, may be recorded on this certificate.

A. Description of original monument and accessories and/or subsequent restoration:

D-10 E-9 9 *

B. Description of corner evidence found and/or method applied in restoring or reestablishing corner:

D-10
ESTABILISH CTR. S-29 AT INTERSECTING 1/4 LINES. THE N 1/4 COR., S-29 IS 2642.43' N AND THE S 1/4 COR., S-29 IS 2639.25' S OF CTR. S-29 AS ESTABILISHED AT INTERSECTION OF 1/4 LINES. THE FD. 1/2 " PIPE W/GROUND WIRE CLAMP IS IN APPROX. CTR. OF E-W DIRT RD. AND 2640' W OF E 1/4 OF S-29!!

E-9
ACCEPTED FD. PIPE FOR NE COR. S-29. PIPE WAS BURIED 3"; 1' E OF CTR. N-S BIT. RD. AND IN APPROX. CTR. OF DIRT RDS. LOOKING E AND W.

9
ESTABILISHED NW COR., NE 1/4, SE 1/4 OF S-29 PER STD. BLM INSTRUCTIONS.

*
ESTABILISHED SE COR., N 1/2, SE 1/4, SE 1/4 OF S-29 PER STD. BLM INSTRUCTIONS.

C. Description of monument for corner and accessories established to perpetuate locating the position of the corner:

D-10
DROVE 5/8"X 34" RE-ROD W/RLS CAP; SET CED. POST W/LOC. TAG.

3" MAPLE	N50°E	69.93'
POWER POLE	N80°W	28.58'
5" MAPLE	S30°W	62.96'
9" MAPLE	S25°E	69.53'
CTR. E-W DIRT RD. DUE S		15'
FD. 1/2" PIPE W/ GND. WIRE CLAMP	S77°23' E	63.19'

E-9
FD. 3/4" PIPE

28"SUG.MAPLE	N25°W	59.49'
6" R. PINE	S60°W	65.10'
32" SUG.MAPLE	S35°W	57.11'
CTR. 4"X4" NBT PEDESTAL	S50°E	46.3'

9
DROVE 5/8"x34" RE-ROD W/ RLS. CAP.

POWER POLE	N80°W	100.87'
NE COR. STONE MASONARY BLDG. FD.	S30°E	74.5'
NE COR. 2'X 3' ROCK	S66°W	87.4'
FN. S'LY	DUE N	138 1'
CTR. E-W DIRT RD	DUE S	2'

*
DROVE 5/8"X 36" RE-ROD W/RLS. CAP; SET CED. POST W/LOC. TAG.

12" B. CHERRY	N20°W	10.3'
9" B. CHERRY	N20°E	16.0'
3" R. OAK	S20°W	6.0'
12" R. OAK	S50°W	28.9'

Signed by Carl F. Roser 12-12-90 Date _____

Surveyor's Michigan License No. 12028

STATE OF MICHIGAN
CARL F. ROSER
LAND SURVEYOR
No. 12028
REGISTERED LAND SURVEYOR

FORM APPROVED BY MICHIGAN STATE BOARD OF LAND SURVEYORS