LAND CORNER RECORDATION CERTIFICATE

Filing Requirement of Act 74, Mich. P.A. 1970

For corners in MECOSTA (County)

Located In: Corner Code #

1. Public Land Survey — T 16 N R 9 W — D-9
2. Property Controlling in Section — S 29 T ____ R ____ — 8
   S 29 T ____ R ____ — 11
3. Miscellaneous Property in Sec. — S ____ T ____ R ____

Register of Deeds Stamp & File Number

4. Lot No. _____ , Recorded Plat _____
5. Private Claims _____

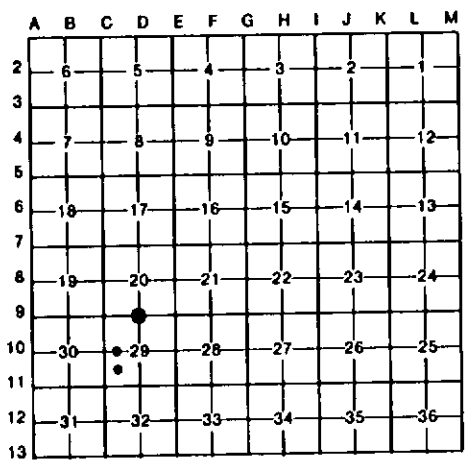

I, CARL F. ROSER, in a field survey on JANUARY, 14TH, 19 89, do hereby certify that under requirements of P.A. 74, Michigan P.A. of 1970, the corner points mentioned in lines 1 and 2 above were in conformance with regulations and rules therefore as required in the current manual of survey instructions of the United States Department of the Interior, Bureau of Land Management or by a decree of a Court of Law and/or that the corner points mentioned in lines 3, 4 and 5 above were in conformance with the rules of the Michigan Board of Land Surveyors or by a Decree of a Court of Law; established, re-established, monumented, re-monumented, recovered, found as expressed below:

NOTE: Not more than 4 corners, all in the same town and range, may be recorded on this certificate.

A. Description of original monument and accessories and/or subsequent restoration:

D-9

D-9 CONT.

8

11

B. Description of corner evidence found and/or method applied in restoring or reestablishing corner:

D-9

RESTORED 1/4 COR. COMMON TO S-20 AND 29 ON LINE BTWN. SEC. CORS. 1/2 MILE TO E AND W. COR IS ON LINE ACROSS FD. OLD CTR. S-20 (FD. OLD 1 1/2" PIPE) AND POSITION FOR N 1/4 S-20 BY OCCUPANCY (CTR. E-W DIT. RD. AND LINE FN. TO N). COR. ALSO FITS DBL. DIST. AND ON LINE ACROSS FD. OLD CTR. S-20 TO N AND FD. 1/8 COR. TO N (COR. FN. POST, OLD FNS. AND

D-9 CONT.

NEW N-S-E-W). THIS 1/4 COR. POSITION LEAVES 2651.57' N TO FD. CTR. S-20 AND 2642.43' S TO CTR. S-29. FD OLD N.W.FN S'LY (S OF RD) IS 41'±2' W. FD OLD FN NL'Y IS 28'±1' W.

8

ESTABILISHED N.W.COR NE 1/4, SW 1/4 OF S-29 PER STD. BLM INSTRUCTIONS.

11

ESTABILISHED NW COR., SE 1/4 SW 1/4 OF S-29 PER STD BLM INSTRUCTIONS. COR. FALLS IN TAMARACK, B. SPRUCE AND BRUSH SWP.

C. Description of monument for corner and accessories established to perpetuate locating the position of the corner:

D-9

DROVE 1" X 5' GALV. PIPE W/RLS CAP; SET CED. POST W/LOC. TAG.

10" MAPLE	N60°W	19.10'
8" T. MAPLE	N40°W	6.65'
9" MAPLE	N20°E	19.11'
9" MAPLE IN CLUMP OF 4	S40°E	15.60'
CTR. E-W DIRT ROAD	DUE S	31'

D-9 CONT.

FD 5/8"X18" RE-ROD S40° 51'W 40.87'

8

DROVE 5/8" X 34" RE-ROD W/RLS CAP; SET CED. POST W/LOC. TAG.

3" MAPLE IN CLUMP OF 3	N40°W	44.23'
4" MAPLE IN CLUMP OF 4	N65°E	50.97'
4" MAPLE	S35°E	69.90'
9" W. PINE	S20°W	93.96'
CTR. E-W DIRT RD.	DUE S	31'

11

DROVE 1" X 80" PIPE W/ RLS CAP; SET CED. POST W/LOC. TAG.

8" TAMARACK	N15°W	21.9'
4" TAMARACK	N15°E	8.1'
5" R. PINE ON ISLAND OF HIGH GRD.	S40°E	108.4'
7" TAMARACK	S45°W	27.2'

Signed by Carl F. Roser 12-12-90 Date _____

Surveyor's Michigan License No. 12028

STATE OF MICHIGAN — CARL F. ROSER — LAND SURVEYOR No. 12028 — REGISTERED LAND SURVEYOR

FORM APPROVED BY MICHIGAN STATE BOARD OF LAND SURVEYORS JAN. 30, 1970 REVISED MAY 1, 1973