

**SURVEY & REMONUMENTATION COMMISSION**  
 APR 10 1995

MECOSTA COUNTY REMONUMENTATION PROGRAM  
 APPROVED BY PEER GROUP ON 12 DECEMBER 1994

**LAND CORNER RECORDATION CERTIFICATE**  
 Filing Requirement of Act 74, Mich. P.A. 1970

STATE OF MICHIGAN  
 COUNTY OF MECOSTA  
 RECEIVED

or corners in Mecosta (County) Located In: \_\_\_\_\_ Corner Code # \_\_\_\_\_

Public Land Survey T 16N R 9W \_\_\_\_\_ A-8 \_\_\_\_\_  
 T \_\_\_\_\_ R \_\_\_\_\_ \_\_\_\_\_  
 T \_\_\_\_\_ R \_\_\_\_\_ \_\_\_\_\_  
 T \_\_\_\_\_ R \_\_\_\_\_ \_\_\_\_\_

Property Controlling in Section S \_\_\_\_\_ T \_\_\_\_\_ R \_\_\_\_\_ \_\_\_\_\_  
 S \_\_\_\_\_ T \_\_\_\_\_ R \_\_\_\_\_ \_\_\_\_\_  
 Miscellaneous S \_\_\_\_\_ T \_\_\_\_\_ R \_\_\_\_\_ \_\_\_\_\_  
 Property in Sec. S \_\_\_\_\_ T \_\_\_\_\_ R \_\_\_\_\_ \_\_\_\_\_

'94 DEC 22 P1:26

*Carl Waldron*  
 REGISTER OF DEEDS

Register of Deeds Stamp & File Number

Lot No. \_\_\_\_\_ Recorded Plat \_\_\_\_\_  
 Private Claims \_\_\_\_\_

	A	B	C	D	E	F	G	H	I	J	K	L	M
2	6	5	4	3	2	1							
3													
4	7	8	9	10	11	12							
5													
6	18	17	16	15	14	13							
7													
8	19	20	21	22	23	24							
9													
10	30	29	28	27	26	25							
11													
12	31	32	33	34	35	36							
13													

Matthew McClung, in a field survey on December 11, 1994 to hereby certify that under requirements of P.A. 74, Michigan P.A. of 1970, the corner points mentioned in lines 1 and 2 above were in conformance with regulations and rules therefore as required in the current manual of survey instructions of the United States Department of the Interior, Bureau of Land Management or by a decree of a Court of Law and/or that the corner points mentioned in lines 3, 4 and 5 above were in conformance with the rules of the Michigan Board of Land Surveyors or by a Decree of a Court of Law; established, re-established, monumented, re-monumented, recovered, found as expressed below:


**NOTE: Not more than 4 corners, all in the same town and range, may be recorded on this certificate.**

1. Description of original monument and accessories and/or subsequent restoration:

The original corner was set by deputy surveyor John Hodgson on 13 October 1837. Volume 2 Field Notes Page 138, set post.  
 Beech 8" S49W 37 lks.  
 Beech 8" N49W 26 lks.

2. Description of corner evidence found and/or method applied in restoring or reestablishing corner:

Set Mecosta County monument 9.0' east of straight line and equal distant between section corners. Corner is 6" North of in line corner post in East R/W fence, and does not fit any fences to west. Corner is 6" West of Road Center Line.

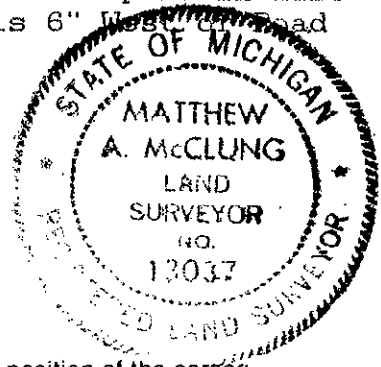

3. Description of monument for corner and accessories established to perpetuate locating the position of the corner:

Corner A-8. Mecosta County Monument, which is a 3" brass cap mounted on a 2 1/2" pipe, 36" in length, and is accepted as the best available evidence of the position of the original corner.  
 3" W. ash N86E 27.81 feet  
 Power Pole N50W 23.48 feet  
 Telephone Pedestal N56W 11.08 feet  
 Iron and Cap #13037 East 33.0 feet

APPROVED BY MECOSTA CO. PEER GROUP  
 IN ACCORDANCE WITH P.A. 349 of 1990  
*James H. Knapp*  
 CHAIRMAN  
 DATE DEC 12, 1994

Signed by Matthew McClung Date December 11, 1994  
 Surveyor's Michigan License No. 13037