

SURVEY & REMONUMENTATION

MECOSTA COUNTY REMONUMENTATION PROGRAM

CORNER APPROVED BY PEER GROUP ON 12 DECEMBER 1994

APR 10 1995

LAND CORNER RECORDATION CERTIFICATE

Filing Requirement of Act 74, Mich. P.A. 1970

STATE OF MICHIGAN
COUNTY OF MECOSTA
REGISTER OF DEEDS

For corners in
Mecosta
(County)

COMMISSION

'94 DEC 22 P1:26

	Located In:	Corner Code #
1. Public Land Survey	T <u>16N</u> R <u>9W</u>	<u>B-9</u>
	T _____ R _____	_____
	T _____ R _____	_____
	T _____ R _____	_____
2. Property Controlling in Section	S _____ T _____ R _____	_____
	S _____ T _____ R _____	_____
3. Miscellaneous Property in Sec.	S _____ T _____ R _____	_____
	S _____ T _____ R _____	_____

Carl Waldron
REGISTER OF DEEDS

Register of Deeds Stamp & File Number

4. Lot No. _____, Recorded Plat _____
5. Private Claims _____

	A	B	C	D	E	F	G	H	I	J	K	L
2	6		5		4		3		2			
3												
4	7		8		9		10		11			
5												
6	18		17		16		15		14			
7												
8	19		20		21		22		23			
9	•											
10	30		29		28		27		26			
11												
12	31		32		33		34		35			
13												

Matthew McClung, in a field survey on December 11, 1994, do hereby certify that under requirements of P.A. 74, Michigan P.A. of 1970, the corner points mentioned in lines 1 and 2 above were in conformance with regulations and rules therefore as required in the current manual of survey instructions of the United States Department of the Interior, Bureau of Land Management or by a decree of a Court of Law and/or that the corner points mentioned in lines 3, 4 and 5 above were in conformance with the rules of the Michigan Board of Land Surveyors or by a Decree of a Court of Law; established, re-established, monumented, re-monumented, recovered, found as expressed below:

NOTE: Not more than 4 corners, all in the same town and range, may be recorded on this certificate.

A. Description of original monument and accessories and/or subsequent restoration:


The original corner was set by deputy surveyor Abner Van Ness on 26 March 1838. Volume 2, Page 167 Field Notes, set post.

Page 12 of County Surveyors Records, Surveyor Robon 2-26-03 Tile
16" Pine N86W 123.8 feet
20 Maple S66E 71.8 feet.

continued on back

B. Description of corner evidence found and/or method applied in restoring or reestablishing corner:

Found D.N.R. Iron and cap 8" below Road surface. Found Tile with 1/2" Rod Bent 90 degrees to SW at 25" below surface Set Mecosta County Monument 6" below road surface, over center of tile.

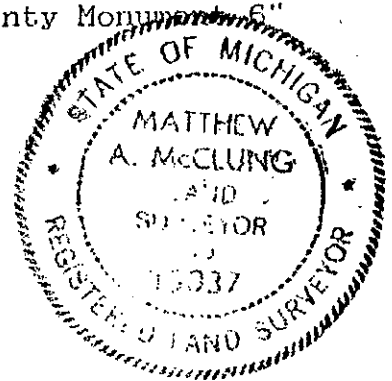

C. Description of monument for corner and accessories established to perpetuate locating the position of the corner:

Corner B-9. Mecosta County Monument, which is a 3" brass cap mounted on a 2 1/2" pipe, 36" in length, and is accepted as a careful and faithful reestablishment of the position of the original corner.

- 12" Elm N45E 44.30' O.B.T.
- 8" Elm N60W 21.34 O.B.T.
- 22" Oak S15W 105.63 feet O.B.T.
- D.N.R. Witness Post West 19.95 feet (Face)

APPROVED BY MECOSTA CO. PEER GROUP
IN ACCORDANCE WITH P.A. 345 OF 1990

James S. Knapp
CHAIRMAN
DATE DEC. 12, 1994

Signed by Matthew McClung Date December 11, 1994

Surveyor's Michigan License No. 13037

Page 175 County surveyor records, Surveyor Willits 4-28-15 tile and iron
8" Elm N69E 79 feet.
10" Elm N 40 E 67 feet

Liber 2, Page 351 Roser 1-15-88 found iron and tile raised to within 0.4"
of road with 5/8" rod to cap # 12028 in center of intersection.
Cedar Post West 33.0 feet.
8" Elm N60W 21.32
11" Elm N60W 21.32
22" Oak S15E 105.63

Lib 2, Page 357 Tingley 11-10-89, Found Roser Iron and Cap.
12" Elm N45W 44.25 feet
8" Elm N45W 21.15 feet
Cedar Post West 33.0 feet
Telephone Pedestal S45E 48.69 feet