

SURVEY & MECOSTA COUNTY REMONUMENTATION PROGRAM
REMONUMENTATION APPROVED BY PEER GROUP ON 12 DECEMBER 1994

corners in
 Mecosta
 (County)

APR 10 1995

COMMISSION

LAND CORNER RECORDATION CERTIFICATE
Filing Requirement of Act 74, Mich. P.A. 1970

STATE OF MICHIGAN
 COUNTY OF MECOSTA
 REGISTER OF DEEDS

'94 DEC 22 P1:26

Carl Waldron
 REGISTER OF DEEDS

Register of Deeds Stamp & File Number

Located In: Corner Code #

Public Land Survey T 16N R 9W C-9
 T _____ R _____
 T _____ R _____
 T _____ R _____
 Property Controlling S _____ T _____ R _____
 in Section S _____ T _____ R _____
 Miscellaneous S _____ T _____ R _____
 Property in Sec. S _____ T _____ R _____

Lot No. _____, Recorded Plat _____
 Private Claims _____

	A	B	C	D	E	F	G	H	I	J	K	L	I
2	6		5		4		3		2				
3													
4	7		8		9		10		11		12		
5													
6	18		17		16		15		14		13		
7													
8	19		20		21		22		23		24		
9													
10	30		29		28		27		26		25		
11													
12	31		32		33		34		35		36		
13													

Matthew McClung in a field survey on December 11, 1994, hereby certify that under requirements of P.A. 74, Michigan P.A. of 1970, the corner points mentioned lines 1 and 2 above were in conformance with regulations and rules therefore as required in the present manual of survey instructions of the United States Department of the Interior, Bureau of Land Management or by a decree of a Court of Law and/or that the corner points mentioned in lines 3, 4 and 5 above were in conformance with the rules of the Michigan Board of Land Surveyors or by a Decree of a Court of Law; established, re-established, monumented, re-monumented, recovered, found as pressed below:

NOTE: Not more than 4 corners, all in the same town and range, may be recorded on this certificate.


Description of original monument and accessories and/or subsequent restoration:

The original corner was set by deputy surveyor Abner Van Ness on 26 March 1838. Volume 2 page 161 Field Notes, set post
 12" Black Ash N72E 39 lks.
 11" Black Ash S31W 32 lks.

continued on back

Description of corner evidence found and/or method applied in restoring or reestablishing corner:

Found 5/8" rod at road surface. Bent 3" to West. Found 3/4" pipe 30" below surface, pipe extended to 40" below surface. Placed Mecosta County monument 6" below surface, over end of pipe.

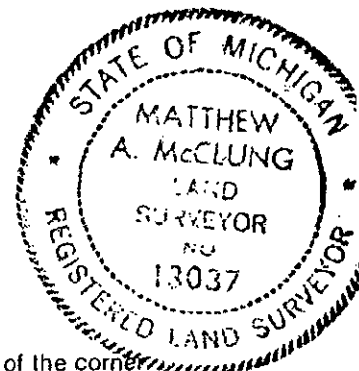

Description of monument for corner and accessories established to perpetuate locating the position of the corner:

Corner C-9. Mecosta County Monument, which is a 3" brass cap mounted on a 2 1/2" pipe, 36" in length, and is accepted as a careful and faithful reestablishment of the position of the original corner.
 5" Maple N55W 31.13 feet O.B.T.
 8" Ash S30E 41.04 feet O.B.T.
 14" Maple 25 West 64.11 feet
 D.N.R. Post South 33.10 feet O.B.P.

APPROVED BY MECOSTA CO. PEER GROUP
 IN ACCORDANCE WITH P.A. 348 of 1990

James H. Knapp
 CHAIRMAN
 DATE DEC. 12, 1994

Witnessed by Matthew McClung
 Surveyor's Michigan License No. 13037

Date December 11, 1994

Lib. 2 Page 349 by Roser
Corner is on line with abandoned road to North. Center Line East & West
Gravel Road South 2.0 feet.
5" Maple (in Clump) N55W 31.13 feet
8" Ash S30W 41.04 feet
9" Maple S30W 26.75 feet
Cedar Post South 33.0 feet

Lib 2, Page 357 Tingley 11-10-89 Found Roser Iron and Cap.
6" Maple in clump N45W 31.5 feet
10" Maple S40W 26.50 feet
10" Oak S35 41.0 feet
Cedar Post South 20 feet