

SURVEY & REMONUMENTATION

MECOSTA COUNTY REMONUMENTATION PROGRAM

SEP 12 1996

CORNER APPROVED BY PEER GROUP ON 12 DECEMBER 1994

COMMISSION

LAND CORNER RECORDATION CERTIFICATE

Filing Requirement of Act 74, Mich. P.A. 1970

STATE OF MICHIGAN COUNTY OF MECOSTA RECEIVED FOR RECORD

For corners in MECOSTA Located In: _____ Corner Code # _____
 (County)

1. Public Land Survey T 16N R 09 W C-8
 T _____ R _____
 T _____ R _____
 T _____ R _____

2. Property Controlling S _____ T _____ R _____
 in Section S _____ T _____ R _____

3. Miscellaneous S _____ T _____ R _____
 Property in Sec. S _____ T _____ R _____

4 Lot No. _____, Recorded Plat _____

5. Private Claims _____

'96 AUG 21 10:37

Joanne Brown REGISTER OF DEEDS

Register of Deeds Stamp & File Number

I, MATTHEW MCCLUNG, in a field survey on DECEMBER 11, 1994
 do hereby certify that under requirements of P.A. 74, Michigan P.A. of 1970, the corner points mentioned in lines 1 and 2 above were in conformance with regulations and rules therefore as required in the current manual of survey instructions of the United States Department of the Interior, Bureau of Land Management or by a decree of a Court of Law and/or that the corner points mentioned in lines 3, 4 and 5 above were in conformance with the rules of the Michigan Board of Land Surveyors or by a Decree of a Court of Law; established, re-established, monumented, re-monumented, recovered, found as expressed below:


	A	B	C	D	E	F	G	H	I	J	K	L	M
1													
2	6	5	4	3	2	1							
3													
4	7	8	9	10	11	12							
5													
6	18	17	16	15	14	13							
7													
8	19	20	21	22	23	24							
9													
10	30	29	28	27	26	25							
11													
12	31	32	33	34	35	36							
13													

NOTE: Only one corner may be recorded on this certificate.

A. Description of original monument and accessories and/or subsequent restoration:
 THE ORIGINAL CORNER WAS SET BY DEPUTY SURVEYOR ABNER VANNESS, ON 26 MARCH 1838.
 VOLUME 2 PAGE 162 FIELD NOTES, SET POST.
 BEECH 8" N48°W 17 LINKS
 BEECH 8" N14°E 14 LINKS

LIBER 2 PAGE 348, ROSER DATED 1-15-88, FOUND 1/2" ROD IN 3" TILE BURIED 1/2' DEEP
 IN OPEN FIELD, IN LINE WITH ROAD TO SOUTH AND APPROXIMATE CENTER LINE OF SPLIT BETWEEN
 60' FENCE REMAINS. SET CEDAR LOCATION POST

B Description of corner evidence found and /or method applied in restoring or reestablishing corner
 FOUND 1/2" ROD AND TILE 1' BELOW SURFACE, PLACED MECOSTA COUNTY MONUMENT 4" ABOVE
 SURFACE OVER CENTER OF TILE AND ROD.

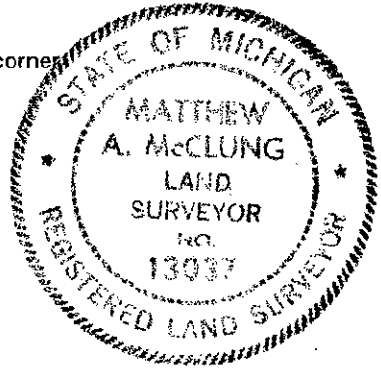

C. Description of monument for corner and accessories established to perpetuate locating the position of the corner:
 CORNER C-8. MECOSTA COUNTY MONUMENT, WHICH IS A 3" BRASS CAP MOUNTED ON A 2-1/2" PIPE, 36" IN LENGTH,
 AND IS ACCEPTED AS A CAREFUL AND FAITHFUL RE-ESTABLISHMENT OF THE POSITION OF THE ORIGINAL CORNER.

- 14" WHITE ASH S05°W 47.74 FEET. O.B.T.
- 8" APPLE S25°W 42.03 FEET O.B.T.
- 6" MAPLE S20°E 57.50 FEET O.B.T.
- DNR POST WEST 1.0 FEET.

APPROVED BY MECOSTA CO. PEER GROUP
 IN ACCORDANCE WITH P.A. 345 of 1990
 James J. Knapp
 CHAIRMAN
 DATE DEC. 12, 1994

Signed by Matthew McClung Date DECEMBER 11, 1994
 Surveyor's Michigan License No. 13037