

**SURVEY &
REMONUMENTATION
MECOSTA COUNTY REMONUMENTATION PROGRAM**

SEP 12 1996 CORNER APPROVED BY PEER GROUP ON AUGUST 24, 1995

COMMISSION

LAND CORNER RECORDATION CERTIFICATE
Filing Requirement of Act 74, Mich. P.A. 1970

STATE OF MICHIGAN
COUNTY OF MECOSTA
RECEIVED FOR RECORD

For corners in MECOSTA Located In: _____ Corner Code # _____
(County)

1. Public Land Survey T 16 N R 10 W _____ E-9 _____
T _____ R _____
T _____ R _____
T _____ R _____

2. Property Controlling S _____ T _____ R _____
in Section S _____ T _____ R _____

3. Miscellaneous S _____ T _____ R _____
Property in Sec. S _____ T _____ R _____

4. Lot No. _____, Recorded Plat _____

5. Private Claims _____

'96 AUG 21 AIO:37

Joann Brown
REGISTER OF DEEDS

Register of Deeds Stamp & File Number

I, JAMES G. KNAPP, in a field survey on JULY 17, 1995, do hereby certify that under requirements of P.A. 74, Michigan P.A. of 1970, the corner points mentioned in lines 1 and 2 above were in conformance with regulations and rules therefore as required in the current manual of survey instructions of the United States Department of the Interior, Bureau of Land Management or by a decree of a Court of Law and/or that the corner points mentioned in lines 3, 4 and 5 above were in conformance with the rules of the Michigan Board of Land Surveyors or by a Decree of a Court of Law; established, re-established, monumented, re-monumented, recovered, found as expressed below:

	A	B	C	D	E	F	G	H	I	J	K	L	M
1													
2	6	5		4		3		2		1			
3													
4	7	8		9		10		11		12			
5													
6	18	17		16		15		14		13			
7													
8	19	20		21		22		23		24			
9													
10	30	29		28		27		26		25			
11													
12	31	32		33		34		35		36			
13													

NOTE: ONLY ONE CORNER MAY BE RECORDED ON THIS CERTIFICATE.

A. Description of original monument and accessories and/or subsequent restoration: DEPUTY SURVEYOR, JOHN HODGSON, SET POST ON SEPT. 4, 1837. CORNER POST PLACED 40.00 CHAINS (2640.00 FEET) FROM 1/4 CORNER COMMON TO SECTIONS 28 AND 29, AND NOTED AS BEING 16.10 CHAINS (1062.60 FEET) NORTH OF A STREAM (8 LINKS WIDE COURSE EAST), AND WITNESSED:

BEECH 7" N38°E 14 LINKS (9.24 FEET)
SUGAR 10" S22°W 10 LINKS (6.60 FEET)

COUNTY SURVEYOR'S RECORD BOOK NO. 1, ON PAGE 44, AT REGISTER OF DEEDS OFFICE, SHOW NOTES BY L. W. JUNE, COUNTY SURVEYOR, IN APRIL, 1898, CORNER NOTED AS, "OLD COR. - PLACED PLOW BEAM, - ELM 16" S32°E, 44 "

ROAD SURVEY NOTES AT MECOSTA COUNTY ROAD COMMISSION BY PAUL HOLLAND, IN APRIL 1919, SHOWS CORNER AND WITNESSED:

F. P. N30°W 35'
MAPLE 6" N40°E 35'

CORNER RECORDED IN LIBER 1, PAGE 284, AS PER P. A. 74 OF 1970, BY DOUGLAS W. HOOTH, P.S. 7966, ON JAN. 27, 1977, AND NOTED AS, "FOUND - END OF PLOW BEAM, 5' WEST OF NORTH - SOUTH ROAD, AND 8' SOUTH OF EAST - WEST RD. BURIED 4", AND WITNESSED:

N37°E 42.80' 30" MAPLE
S45°W 26.39' FE. POST
N20°W 50.19' FE. POST
S20°W 50.60' TEL. POST
N27°E 14.00' REINF. ROD


APPROVED BY MECOSTA CO. PEER GROUP
IN ACCORDANCE WITH P.A. 345 OF 1990

James G. Knapp
CHAIRMAN
DATE AUG. 24, 1995

B. Description of corner evidence found and/or method applied in restoring or reestablishing corner: FOUND PLOW BEAM, BURIED 2" BELOW ROAD SURFACE, ON SOUTH EDGE OF 20 MILE ROAD (18' GRAVEL) AND 4' WEST OF CENTER OF 220TH. (18' GRAVEL). FOUND 5/8" RE-ROD AT AZ. 27°, 14.00' (LEFT AS FOUND), AND ROTTED FALLEN REMAINS OF 34" MAPLE AT AZ. 37°, 42.8'. CORNER LOCATION IS 1046 FEET NORTH OF A 24" CSP CULVERT, WHICH IS 16'± NORTH OF ORIGINAL STREAM POSITION.

C. Description of monument for corner and accessories established to perpetuate locating the position of the corner: E-9 - SECTION CORNER COMMON TO SECTIONS 20, 21, 28, AND 29, T16N-R10W. FOUND PLOW BEAM AND IS ACCEPTED AS A CAREFUL AND FAITHFUL PERPETUATION OF THE POSITION OF THE ORIGINAL CORNER. REMOVED PLOW BEAM AND SET IN THE SAME POSITION A STANDARD MECOSTA COUNTY REMONUMENTATION MONUMENT, WITH BROKEN PIECES OF THE PLOW BEAM PLACED AROUND THE BOTTOM OF THE MONUMENT.

SET 60d SPIKE W/REMONUMENTATION WITNESS TAG IN SOUTH SIDE	14" ELM	AZ. 62°,	87.52 FEET
TELEPHONE PEDESTAL (No. 21990)		AZ. 120°,	43.38 FEET
SET 60d SPIKE W/REMONUMENTATION WITNESS TAG IN N.W. SIDE	CORNER FENCE POST	AZ. 225°,	25.36 FEET
SET 60d SPIKE W/REMONUMENTATION WITNESS TAG IN EAST SIDE	UTILITY POLE	AZ. 315°,	96.20 FEET

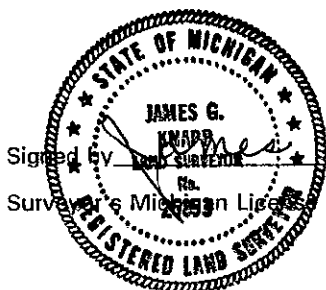

Signed by James G. Knapp Date MAY 28, 1996
Surveyor's Michigan License No. 25853