

JAN 21 1999

APPROVED LAND CORNER
P.A. 345 OF 1990
MIDLAND COUNTY

SECTION
REMON. CORNER E-5, MT. HALEY TWP.
LAND CORNER RECORDATION CERTIFICATE
Filing Requirement of Act 74, Mich. P.A. 1970

392

For corners in
MIDLAND

(County)

Located In: Corner Code #

- 1. Public Land Survey T 13N R 1E E-5
T ___ R ___
T ___ R ___
T ___ R ___
- 2. Property Controlling in Section S ___ T ___ R ___
S ___ T ___ R ___
- 3. Miscellaneous Property in Sec. S ___ T ___ R ___
S ___ T ___ R ___

STATE OF MICHIGAN
MIDLAND COUNTY
REMONUMENTATION & FILED

12/16/1998 12:11:56 PM

BEVERLY J. THAYER
REGISTER OF DEEDS

Register of Deeds Stamp & File Number

- 4. Lot No. _____, Recorded Plat _____
- 5. Private Claims _____

I, RODNEY CLAYPOOL, in a field survey on June 6, 1998, do hereby certify that under requirements of P.A. 74, Michigan P.A. of 1970, the corner points mentioned on lines 1 and 2 above were in conformance with regulations and rules therefore as required in the current manual of survey instructions of the United States Department of the Interior, Bureau of Land Management or by a decree of a Court of Law and/or that the corner points mentioned in lines 3, 4 and 5 above were in conformance with the rules of the Michigan Board of Land Surveyors or by a Decree of a Court of Law; re-established, monumented, re-monumented, recovered, found as expressed below:


NOTE: Not more than 2 corners, all in the same town and range, may be recorded on this certificate.

	A	B	C	D	E	F	G	H	I	J	K	L	M
2	6	5	4	3	2	1							
3													
4	7	8	9	10	11	12							
5													
6	18	17	16	15	14	13							
7													
8	19	20	21	22	23	24							
9													
10	30	29	28	27	26	25							
11													
12	31	32	33	34	35	36							
13													

A. Description of original monument and accessories and/or subsequent restoration:

E-5 Corner common to Sections 9 and 16 on West Townline

Survey by Glo, 1830, set post
Survey by Gibbs, 1909 & 1915, set post and stone
Survey by Ledy, 1990 & 1993, found 3/4" rod in monument box

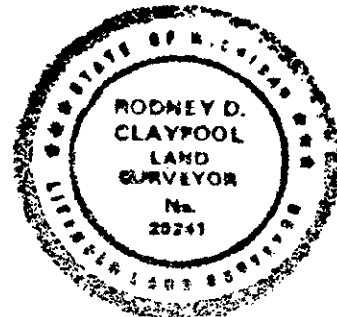

WITNESS NOTE: Witnesses from above surveys and LCRC's are available in dossier file; which was presented to peer review committee and is on file at the Register of Deeds Office.

B. Description of corner evidence found and/or method applied in restoring or reestablishing corner:

E-5 Corner common to Sections 9 and 16 on West Townline

Found bolt spike in monument box per survey by Ledy

C. Description of monument for corner and accessories established to perpetuate locating the position of the corner:

E-5 Corner common to Sections 9 and 16 on West Townline

Found bolt spike in monument box per surveys by Ledy, replaced bolt with 5/8" rod and brass cap stamped Midland Co. Remon corner PS 29241 and is accepted as the best available evidence of the position of the accepted corner.

- S 88 Deg W, 49.10 ft, Pk nail in power pole
- N 60 Deg W, 70.57 ft, nail in 10" Oak
- S 50 Deg E, 68.19 ft, nail and plastic disc in 5" Oak
- N 45 Deg E, 73.34 ft, nail and plastic disc in 5" Oak
- Glo 501.6', R- M- 456.7
- 3ft East of centerline M-30
- 7ft South of centerline Brooks Road

Signed by Rodney D. Claypool

Date 12-04-98

Surveyor's Michigan License No. 29241