SURVEY &
REMONUMENTATION

JAN 21 1999

APPROVED LAND CORNER
P.A. 345 OF 1990
MIDLAND COUNTY

11/24/98 GFG

REMON. CORNER G-5, MT. HALEY TWP. SECTION 391

LAND CORNER RECORDATION CERTIFICATE
Filing Requirement of Act 74, Mich. P.A. 1970

STATE OF MICHIGAN
MIDLAND COUNTY
REMONUMENTATION & FILED

12/16/1998 12:11:56 PM

BEVERLY J. THAYER
REGISTER OF DEEDS

Register of Deeds Stamp & File Number

For corners in MIDLAND (County)

		Located in:	Corner Code #
1. Public Land Survey		T 13N R 1E	G-5
		T ___ R ___	
		T ___ R ___	
		T ___ R ___	
2. Property Controlling	S ___	T ___ R ___	
in Section	S ___	T ___ R ___	
3. Miscellaneous	S ___	T ___ R ___	
Property in Sec.	S ___	T ___ R ___	

4. Lot No. _____, Recorded Plat _____
5. Private Claims _____

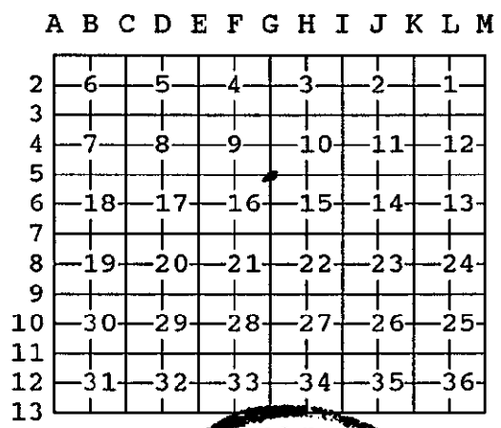

I, RODNEY CLAYPOOL, in a field survey on June 19, 1998, do hereby certify that under requirements of P.A. 74, Michigan P.A. of 1970, the corner points mentioned on lines 1 and 2 above were in conformance with regulations and rules therefore as required in the current manual of survey instructions of the United States Department of the interior, Bureau of Land Management or by a decree of a Court of Law and/or that the corner points mentioned in lines 3, 4 and 5 above were in conformance with the rules of the Michigan Board of Land Surveyors or by a Decree of a Court of Law; re-established, monumented, re-monumented, recovered, found as expressed below:

NOTE: Not more than 2 corners, all in the same town and range, may be recorded on this certificate.

STATE OF MICHIGAN
RODNEY D. CLAYPOOL
LAND SURVEYOR
No. 29241
LICENSED LAND SURVEYOR

A. Description of original monument and accessories and/or subsequent restoration:

G-5 Corner common to Sections 9, 10, 15 and 16

Survey by Glo, 1830's, set post
Survey by Dow Chemical Co., 1954, set 3/4" pipe
Survey by Hunter-Whittier, 1968, 1969, 1971, 1972, 1978, 1980, 3/4' pipe in monument box
Survey by Ayres Associates, 1980, monument box
Survey by Ledy, 1990, 3/4" pipe in monument box

WITNESS NOTE: Witnesses from above surveys and LCRC's are available in dossier file; which was presented to peer review committee and is on file at the Register of Deeds Office.

B. Description of corner evidence found and/or method applied in restoring or reestablishing corner:

G-5 Corner common to Sections 9, 10, 15 and 16

Found 3/4" pipe in monument box per surveys by Dow Chemical Co., Hunter-Whittier, Ayres Associates and Ledy.

C. Description of monument for corner and accessories established to perpetuate locating the position of the corner:

G-5 Corner common to Sections 9, 10, 15 and 16

Found 3/4" pipe in monument box per surveys by Dow Chemical Co., Hunter-Whittier, Ayres Associates and Ledy. Replaced pipe with 5/8" rod with brass cap stamped Midland Co. Remon Cor. PS 29241, and is accepted as the best available evidence of the position of the accepted corner.

N 70 Deg W, 70.55 ft, nail and disc in power pole
S 70 Deg W, 85.65 ft, nail and tag in power pole
S 45 Deg E, 67.36 ft, nail and tag in power pole (OBT)
N 40 Deg W, 65.65 ft, nail and plastic disc in 12" Oak

Signed by Rodney D. Claypool Date 12-04-98

Surveyor's Michigan License No. 29241

Form approved by Michigan State Board of Land Surveyors, Jan. 28, 1971
Revised May 14, 1971
Revised Jan., 1983